#### SECTION 00911 - ADDENDUM 1

#### 1.1 PROJECT INFORMATION

- A. Project Name: South Main Corridor Improvement Project (Phase II)
- B. Engineer: SK Design Group, Inc.
- C. Engineer's Project Number: 16-108.
- D. Date of Addendum: 2024-05-03

#### 1.2 NOTICE TO BIDDERS

- A. This Addendum is issued to all registered plan holders pursuant to the Instructions to Bidders and Conditions of the Contract. This Addendum serves to clarify, revise, and supersede information in the Project Manual, Drawings, and previously issued Addenda. Portions of the Addendum affecting the Contract Documents will be incorporated into the Contract by enumeration of the Addendum in the Owner/Contractor Agreement.
- B. The Bidder shall acknowledge receipt of this Addendum in the appropriate space on the Bid Form.
- C. The date for receipt of bids is unchanged by this Addendum at same time and location.

#### 1.3 ATTACHMENTS

- A. This addendum includes the following attached documents:
  - 1. Pre-bid meeting notes with associated attendees list.
  - 2. Electronic media transfer agreement.
  - 3. Sheet C20.01
  - 4. Sheet C30.03
  - 5. Sheet C30.04
  - 6. Sheet C33.15
  - 7. Sheet C33.16
  - 8. Sheet C33.17
  - 9. Sheet C33.18
  - 10. Sheet SE002
  - 11. Sheet SE002
  - 12. Sheet SE204

#### 1.4 GENERAL REVISIONS

A. Project CAD files are available to contractors upon receipt by <u>annlint@skdg.com</u> of a completed, signed Electronic Media Transfer Agreement, which is attached.

#### 1.5 QUESTIONS AND RESPONSES

A. Question: On Sheet C20.01 it indicates that precast inlet tops are allowed on the project. However, on sheet C30.04 Note 1 it indicates that if the structures are precast that the tops must be cast in place. Can you clarify if precast tops are allowed?

**Response:** Notes on Sheets C30.03 and C30.04 are revised to match that on Sheet C20.01. Precast inlet tops are acceptable as long as the top slopes with the pavement grades.

B. Question: On sheet SE201 it calls out to install junction box (J11) however On sheet SE002 there is no mention of a junction box when identifying the runs or on the left side of the page that shows quantities of junction boxes. Please clarify if a junction box is to be installed?

**Response:** SE002 has been revised to include J11 to match the plans. See attached.

- C. Question: On sheet SE002 the table on the left side of the page seems to have a discrepancy with the total quantities of each column. Please clarify/update column with the correct totals. **Response: SE002 has been revised. See attached.**
- D. Question: On Sheet SE204 the plans identify Controller F to be a 2CKT controller, however on sheet SE002 the table calls out Controller F to be a 4CKT. Please clarify which size of controller is required.

# **Response:** Keynote 5 on Sheet SE204 has been revised to reflect Controller F to be a 4 CKT controller. SE303 and SE002 remain correct indicating a 4CKT controller. See attached.

E. Question: There seems to be a discrepancy with the routing of conduit On sheet SE 204 compared to what is called out on SE002. Sheet SE002 indicates a conduit from F201 to J8. Sheet SE204 does not show this and 3 conduits in a screw in base will be difficult. Please clarify routing.

# **Response:** Routing is shown correctly on SE204. SE002 has been revised to reflect plan sheet. See attached.

#### 1.6 DRAWINGS

- A. Sheet C20.01: Revised to remove nighttime work language.
- B. Sheet C30.03: Revised to indicate precast inlet top is acceptable as long as the top slopes with the pavement grades.
- C. Sheet C30.04: Revised to indicate precast inlet top is acceptable as long as the top slopes with the pavement grades.
- D. Sheet C33.15: Revised to remove nighttime work language.
- E. Sheet C33.16: Revised to remove nighttime work language.
- F. Sheet C33.17: Revised to remove nighttime work language.
- G. Sheet C33.18: Revised to remove nighttime work language.

South Main Corridor Improvement Project (Phase II) STP-4301 (104) and TAP-4301 (106) City of Maryville, MO

- H. Sheet SE002: Revised for clarification.
- I. Sheet SE003: Revised for clarification.
- J. Sheet SE204: Revised for clarification.
- 1.7 SPECIFICATIONS
  - A. The date on the project manual cover page is revised.

PART 2 - PRODUCTS - NOT USED -

PART 3 - EXECUTION - NOT USED -

END OF SECTION 00911

#### CIVIL ENGINEERS SINCE 1989

City of Maryville, Missouri

South Main Improvement Phase II & Pedestrian Enhancements Project #'s: STP-4301104 and TAP-4301106 Pre-Bid Meeting Notes – April 30, 2024, at 1:00 p.m.

I. Introductions

Please Sign-in

City Personnel

	Name, Title	Email	Phone
	Greg McDanel, City Manager	gmcdanel@maryville.org	660-541-1353
	Ryan Heiland, Assistant City Manager	rheiland@maryville.org	660-541-4402
	Matt Smith, Public Works Director	msmith@maryville.org	660-562-8025
	Stacy Wood, City Clerk	swood@maryville.org	660-562-8003
Eng	ineer's Personnel: SK Design Group	, Inc. 913-451-1818	

$\sim$			
	Name, Title	Email	Phone
	Sassan Mahobian, Principal in Charge	sassan@skdg.com	913-238-3178
	Stephen Brefo, Project Manager, Submittals	sbrefo@skdg.com	816-510-1126
	Mehrdad Givechi, Traffic Signals	mgivechi@sunflower.com	785-766-0712
	Chris Francisco, Field Project Manager	cfrancisco@skdg.com	816-726-7089
	Field Representative	To Be Determined	

Engineer's Consultants:

Name, Company	Email	Phone
Adam Teal, Midland Survey	ateal@midlandsurvey.com	660-582-8633
Kathi Vandel, LightWorks	kathi@lightworkskc.com	816-352-6007
Doug Pickert, Indigo	doug@indigoparks.com	913-583-1370
Dylan Kruger, KTI	dzkruger@ktionline.com	913-498-1114

II. Overview of Project Intent, Goals, Objectives

The Work consists of reconstruction of a section of South Main Street Corridor from State Highway V to 285<sup>th</sup> Street, including:

- Storm sewer system improvement
- Full depth street widening
- Mill and overlay
- Traffic signals
- Lighting
- Curb & sidewalk replacement
- Landscaping
- Improvement to existing driveway access.

The selected Bidder will construct the project, complete related services described in the contract documents and place the project into service in accordance with the plans and specifications.

#### CIVIL ENGINEERS SINCE 1989

5K

City of Maryville, Missouri South Main Improvement Phase II & Pedestrian Enhancements Pre-Bid Meeting Notes

III. Schedule

- Questions, Comments and Requests for Clarifications Due to Engineer by Thursday May 2, 2024, before 5:00 p.m.
- Response to Bidder Questions if necessary (Addendum) by Tuesday May 7, 2024.
- Public Bid Opening May 14, 2024, at 2:00 p.m. Note: Bids will be received by the City of Maryville at the Maryville Public Safety Facility, 101 N. Vine Street, Maryville, Missouri 64468 until 2:00 pm on May 14, 2024.
- Contract Award / Notice to Proceed TBD
- Period of Performance: 540 Calendar Days
- Final Completion TBD

#### IV. Bidder Checklist

- Submit completed Contractor Questionnaire and/or Contractor Prequalification Questionnaire with attachments not later than seven (7) days prior to the date and hour of the bid opening.
- For submittal of paper bids, the complete set of bidding documents includes all information through the DBE forms.
- If submitting the bid by mail, it is to be completed, executed, and submitted in a sealed envelope addressed to the City of Maryville, MO.
  - Provide the vendor name, vendor address, vendor number, county, route and federal project number on the outside of the envelope (if applicable).
- Please read all items in the bidding document carefully. For paper bids, complete all items in ink or by typing in the information.
- Sign this bidding document properly.
- For paper bids submit a bid bond executed by bidder and surety or attach cashier's check to the bid bond form.
- Submit the DBE Submittal Forms within 3 business days of the Bid Opening.
- For paper bids, staple addenda to the bid in the appropriate part of the bid.
  - The letter accompanying the addenda should be stapled to the inside of the back cover of the bid and returned.

#### V. Disadvantaged Business Enterprise (DBE)/Buy America/Prevailing Wage/Trainees

- The overall goal for DBE participation for this project is **6%**.
  - The Bidder shall also complete the DBE Submittal Forms as required.
- This project falls under Title 23, CFR, titled Buy America Requirements.
  - Buy America certifications will be required on all applicable materials.
- This contract requires payment of the prevailing hourly rate of wages for each craft or type of work required to execute the contract as determined by the Missouri Department of Labor and Industrial Relations or federal rates, whichever is higher.

#### CIVIL ENGINEERS SINCE 1989

City of Maryville, Missouri South Main Improvement Phase II & Pedestrian Enhancements Pre-Bid Meeting Notes • Training provisions: Provision in the Missouri Highways and Transportation Commission's "General Provisions and Supplement Specifications" which are available on the Missouri Department of Transportation web page at www.modot.mo.gov under "Business with MoDOT" "Standards and Specifications". The number of trainee hours provided under this contract will be <u>two slot</u> for <u>1000</u> hours per slot.

VI. Job Special Provisions

- Traffic management schedule shall be submitted to the engineer by contractor prior to the start of work.
  - This should be submitted to the engineer as soon as possible to mitigate delay after NTP is issued.
- Holiday Restrictions: Memorial Day, Independence Day, Labor Day.
  - All lanes shall be scheduled to be open to traffic during holiday periods from 12:00 Noon on the last working day preceding the holiday until 9:00AM on the first working day subsequent to the holiday.
- Night-time paving will be required. For specific requirements, see notes on drawing C20.01.
- Liquidated Damages may be assessed at \$4300/day if work is not complete on time.
- Utility contacts
- Letters of Certification. Utilities "Status" Letter
  - Evergy has facilities that must be relocated if Alternate 1 is accepted by the City. The extent of relocations is shown on the plans. Contractor's responsibilities are identified on the plans. (Alternate 1)
  - Telecom lines will need to be relocated and coordinated with the telecom companies if Alternate 1 is accepted by the City. Contractor's responsibilities are identified on the plans. (Alternate 1)
  - Gas lines will need to be relocated and coordinated with the gas company. Contractor's responsibilities are identified on the plans.
  - Waterlines will need to be relocated under this contract
- Order of work: Refer to Drawing C20.01.
- ADA per plans and reviewed per MODOT checklist
- Possession of Right-of-Way: There is no delayed possession of right-of-way on the project.

#### VII. Project Documents

• Copies of plans and specifications and addenda can be seen or purchased for a Non-Refundable fee on-line at www.drexeltech.com in their eDistribution plan room, additional assistance is available at <u>distribution@drexeltech.com</u>.

VIII. General Notes

• Enhanced communication between City and selected contractor will be critical.

#### CIVIL ENGINEERS SINCE 1989

City of Maryville, Missouri South Main Improvement Phase II & Pedestrian Enhancements Pre-Bid Meeting Notes SK

- Management of traffic between 2:30 3:30 p.m. each day will be important with shift change at Kawasaki. Scheduling of major construction activities to avoid these times may be unavoidable, but ideal when possible.
- Following bid opening, the City will request bid concurrence with MoDOT, and contract approval by City Council is expected as soon as possible.

VIII. Post Meeting Clarification

• Night-time paving is not required, however contractor may choose to pave at night at no additional cost to City.

CIVIL ENGINEERS SINCE 1989

#### City of Maryville, Missouri

South Main Improvement Phase II & Pedestrian Enhancements STP-4301104 and TAP-4301106 Pre-Bid Meeting Sign In Sheet – April 30, 2024, at 1:00 p.m.

COMPANY PHONE EMAIL ADDRESS NAME Andrew Killen 660-216-8659 aKillen@hardyhddinggan Phillips Herdy Phillips Hordy 8/6/016-6392 mhall@phillips like f eremy Car Hon Infrastructure solutions 913-775-1201 Jearlton @1-Solutions/16.50 revor Kratzberg Lexeco 913-727-1234 estimating@lexeco.com RS Electric W. lit 1 816-215-0284 ot @ RSelectric ut. lity. co City of Macyville justinutabuilderse 816.885-3891 816-387.3408 lonnicwales 59 egma JD Bishop Wolss CITY OF MANYHUE 660-562-8001 GREG MCDANEL 9 midenel@ vood@maryville.oro City of Maryville 660-562-8003 Su 000 SK DESIGN GROUP 913-451-1818 EPHEN SREFO



#### **ELECTRONIC MEDIA TRANSFER AGREEMENT**

This Electronic Media Transfer Agreement (this "Agreement") is entered into by

\_\_\_\_(Contractor)

(the "Licensee")

and **SK Design Group, Inc.** (the "Licensor"). The Licensee has requested that the Licensor provide certain design, drawings and data in an electronic media format ("Electronic Media") for the **South Main Phase II** project (the "Project").

Electronic Media being transmitted or transferred may contain Civil 3D data, Pipe networks, road profiles, existing and proposed surfaces, surfaces for options studied, computer aided drafting documents, digital modeling, audio, video and/or other graphic images, drawings or designs created or stored for the Project in digital form. In consideration of the Licensor furnishing such Electronic Media to Licensee, Licensee agrees as follows:

- 1. Due to the potential that the information set forth in the Electronic Media can be modified by the Licensee or others, unintentionally or otherwise, the Licensee shall remove all references to the Licensor's corporate name, professional seal, and/or involvement from each electronic display, if such exists.
- 2. The data in the Electronic Media represents Project information at a particular point in time and Licensor shall not be responsible to advise Licensee of any changes which may thereafter be made to the Project data or other information transmitted in electronic format. Licensor makes no representation regarding the accuracy or completeness of the Electronic Media transferred or transmitted. In the event that a conflict arises between the signed contract documents for the Project which are prepared by Licensor and the Electronic Media, the signed contract documents shall govern. Licensee is responsible for determining if any conflict exists. Licensor's electronic files are constantly being updated and are not always posted on Licensor's FTP site. Licensee is responsible for requesting updates.
- 3. Licensor grants to Licensee a limited license to reproduce such information in connection with work on the Project, and for no other purpose. Granting a limited license for use of the Electronic Media shall not be constructed as forming a contractual relationship between the Licensee or any of its agents or assigns. This limited license to use and reproduce information is granted only to the Licensee named in this Agreement and expressly prohibits copying or transmission of the Electronic Media for use by any other party.
- 4. The Licensor specifically disclaims all warranties, expressed or implied, including, but not limited to implied warranties of merchantability and fitness for a particular purpose, with respect to the Electronic Media and the information contained therein. The Licensor shall have no liability with respect to any claim, demand, loss, or damage directly or indirectly arising out of the use of the Electronic Media. Further, Licensor shall have no liability for consequential damages, including without limitation damages arising from the actual or alleged negligence of the Licensor.
- 5. The parties understand that the data contained in the Electronic Media may be altered intentionally or otherwise due to occurrences beyond the reasonable control or knowledge of the Licensor. These may include errors in transcription, machine error, environmental factors, as well as operator error. Further, the data contained on the Electronic Media may be inaccurate or otherwise flawed at the time of transmittal to the Licensee. Licensee, as part of the consideration for accepting the delivery of the Electronic Media and its use, agrees to indemnify, defend, and hold harmless the Licensor, its consultants, and their respective officers, directors, employees, members, and owners from any claims, liabilities, loss and costs, including but not limited to, attorneys' fees and cost of defense arising out of the use of the Electronic Media by Licensee, or others, if released to such parties by Licensee.
- 6. It shall be the Licensee's responsibility to verify that the information contained within the Electronic Media conforms to all contract requirements for the Project. Should there be any discrepancy, Licensee agrees to notify the Licensor immediately. If notified within, but not later than, fourteen (14) days of the delivery of the Electronic Media, Licensor may elect to revise the Project Electronic Media, and, if so, will provide a revised copy of the Electronic Media, which corrects the discrepancy, if requested by Licensee. This shall be the sole remedy available for any defect.

Licensor: SK Design Group, Inc.	Licensee: (Co	ntractor)
By: Same meholus	By:	
Name: Sassan Mahobian, PE, LEED AP, ENV SP	Name:	
Title: President	Title:	
Date: 2024-05-02	Date:	

### GENERAL NOTES

- 1. ALL CONSTRUCTION SHALL COMPLY WITH AMERICAN PUBLIC WORKS ASSOCIATION (APWA) AND MISSOURI STANDARD SPECIFICATIONS FOR HIGHWAY CONSTRUCTION UNLESS NOTED OTHERWISE BY PLANS AND SPECS.
- 2. ALL WORKMANSHIP AND MATERIALS SHALL BE SUBJECT TO INSPECTION AND APPROVAL OF THE MISSOURI DEPARTMENT OF TRANSPORTATION (MoDOT)
- 3. LINEAL FOOT MEASUREMENTS SHOWN ON THE PLANS ARE HORIZONTAL MEASUREMENTS. ALL PAYMENTS SHALL BE MADE ON HORIZONTAL MEASUREMENTS.
- 4. ALL WASTE MATERIAL RESULTING FROM THE PROJECT SHALL BE DISPOSED OF OFF-SITE BY THE CONTRACTOR IN ACCORDANCE WITH LOCAL, STATE AND FEDERAL REGULATIONS.
- 5. ALL EXCAVATION SHALL BE UNCLASSIFIED. NO SEPARATE PAYMENT WILL BE ADJUSTED FOR THIS PROJECT. 6. THE CONTRACTOR IS RESPONSIBLE FOR ALL PERMITS AND FEES.
- 7. THE CONTRACTOR IS RESPONSIBLE FOR ALL TRAFFIC CONTROL. THE CONTRACTOR SHALL PROVIDE TRAFFIC CONTROL AS RECOMMENDED BY M.U.T.C.D.
- 8. THE CONTRACTOR SHALL MAINTAIN DRAINAGE AND EROSION CONTROL DURING CONSTRUCTION AND IS RESPONSIBLE FOR ALL DE-WATERING NECESSARY DURING CONSTRUCTION. THE CONTRACTOR SHALL BE RESPONSIBLE FOR ALL PERMITTING FOLLOWING LOCAL. STATE. AND FEDERAL EROSION AND SEDIMENTATION CONTROL REQUIREMENTS. ALL EROSION CONTROL MEASURES SHALL BE INSTALLED IN ACCORDANCE WITH KC METRO APWA STANDARD DRAWINGS.
- 9. THE CONTRACTOR SHALL VERIFY THAT THE SOIL CONDITIONS ARE SUITABLE FOR PLANTING AND WILL BE ACCEPTABLE FOR PROPER GROWTH OF THE PROPOSED PLANT MATERIALS PER SPECIFICATIONS. THIS SHALL BE INCLUDED IN THE BASE BID AND BE NO CAUSE FOR ADDITIONAL COST TO THE OWNER.
- 10. THE CONTRACTOR SHALL GRADE AND OTHERWISE RESTORE ALL DISTURBED AREAS TO A CONDITION READY FOR SEEDING AND SODDING, TOPSOIL IS TO BE PLACED OVER ALL DISTURBED AREAS. PLACE TOPSOIL TO BRING PROPOSED GRADES BACK TO EXISTING CONDITION. GRADE TOLERANCES IN NON-PAVED AREAS FOR THIS PROJECT IS 0.10 FEET.
- 11. THE ENGINEER AND THE OWNER SHALL APPROVE ALL FINAL GRADES AND CONDITION OF SITE PRIOR TO SEEDING AND SODDING OPERATIONS. FINISH TURF (SEED AND SOD) TO BE FLUSH WITH ADJOINING PAVEMENT SURFACES.
- 12. WRITTEN DIMENSIONS SHALL PREVAIL OVER SCALED DIMENSIONS.
- 13. UTILITY SERVICE LINES, POLES, VALVE BOXES, METERS, ETC. MUST BE ADJUSTED AS NECESSARY, BY EACH RESPECTIVE UTILITY OWNER, PRIOR TO CONSTRUCTION, UNLESS THE PLANS SPECIFICALLY CALL FOR THEIR ADJUSTMENT BY THE CONTRACTOR. THE CONTRACTOR WILL BE REQUIRED TO WORK AROUND EXISTING UTILITIES WITHIN THE RIGHT-OF-WAY WHICH DO NOT CONFLICT WITH PROPOSED CONSTRUCTION
- 14. THE INFORMATION SHOWN IN THESE PLANS CONCERNING TYPE AND LOCATION OF UNDERGROUND UTILITIES IS NOT GUARANTEED TO BE ACCURATE OR ALL INCLUSIVE. EXISTING UTILITIES AND THEIR LOCATIONS, AS SHOWN ON THE PLANS, REPRESENT THE BEST INFORMATION OBTAINABLE FOR DESIGN. THE CONTRACTOR IS RESPONSIBLE FOR MAKING HIS OWN DETERMINATIONS AS TO THE TYPE AND LOCATION OF UNDERGROUND UTILITIES AS MAY BE NECESSARY, TO AVOID DAMAGE THERETO. THE CONTRACTOR MUST NOTIFY ALL UTILITIES 48 HOURS PRIOR TO ANY EXCAVATION.
- 15. NEW AND EXISTING INLET AND MANHOLE COVERS SHALL BE ADJUSTED TO THE SAME SLOPE AS ADJACENT SURFACES.
- 16. BORROW AREAS PROVIDED BY THE CONTRACTOR SHALL BE APPROVED BY THE ENGINEER AS TO SUITABILITY OF MATERIAL AND LOCATION. SPECIAL CARE SHALL BE TAKEN IN THIS APPROVAL TO MINIMIZE THE INCREASE OF SILTATION AND TURBIDITY OF STREAMS, LAKES AND RESERVOIRS AND TO AVOID INTERFERENCE WITH THE MOVEMENT OF MIGRATORY FISH. AREAS WHICH, IN THE OPINION OF THE ENGINEER, MAY LEAVE AN UNSIGHTLY APPEARANCE TO THE PROJECT WILL NOT BE APPROVED. IT SHALL BE THE RESPONSIBILITY OF THE CONTRACTOR TO RESTORE, SEED AND/OR COMPLETE OTHER OPERATIONS NOTED IN THE AGREEMENT WITH THE OWNER, APPROVED BY THE ENGINEER, ON ALL DISTURBED AREAS.
- 17. ALL PAVEMENT AND SIDEWALKS TO BE REMOVED SHALL BE SAW CUT. ANY PAVEMENT OR SIDEWALKS DAMAGED BEYOND THE ORIGINAL SAW CUT LIMITS (AS SHOWN ON THE PLAN OR DETERMINED IN THE FIELD) SHALL BE RE-SAWED TO PROVIDE AN EVEN JOINT AND REPLACED AT THE CONTRACTOR'S EXPENSE.
- 18. PAVEMENT AND SIDEWALK REMOVAL LIMITS SHOWN ARE APPROXIMATE AND MAY BE CHANGED DUE TO GRADE CONSIDERATIONS OR OTHER FIELD CONDITIONS, AS APPROVED BY ENGINEER.
- 19. ALL SAW CUTS SHALL BE FULL DEPTH.
- 20. CONTRACTOR SHALL MAINTAIN CONSTRUCTION LIMITS WITHIN THE EXISTING AND/OR PROPOSED **RIGHT-OF-WAYS AND EASEMENTS.**
- 21. CONTRACTOR SHALL BE RESPONSIBLE FOR DIVERTING STORM SEWER RUNOFF INTO THE PROPOSED STORM SEWER SYSTEM DURING CONSTRUCTION. TEMPORARY CONNECTIONS SHALL BE MADE, AS APPROVED BY ENGINEER, TO ELIMINATE FLOODING AND PONDING PRIOR TO COMPLETION OF THE PROPOSED STORM SEWER.
- 22. ALL TOPS FOR PRECAST CURB INLETS CAN BE PRECAST OR CAST IN PLACE. IF INLET TOPS ARE CAST IN PLACE, THE PRECAST INLET WALL STEEL SHALL BE LEFT EXPOSED TO A HEIGHT 2" BELOW THE FINISH TOP ELEVATION. ALL STRUCTURE TOPS MUST MATCH ADJACENT GRADES. ALL LABOR, MATERIALS, AND EQUIPMENT NECESSARY TO COMPLETE THIS WORK SHALL BE INCLUDED IN THE BID.
- 23. UNTREATED COMPACTED AGGREGATE (APWA) OR MoDOT TYPE 5 AGGREGATE COMPACTED TO 95% STD. MAX. DENSITY SHALL BE USED TO BACKFILL ALL TRENCHES LOCATED WITHIN 2 FEET OF PAVEMENT, CURB AND GUTTER, AND SIDEWALK. IN AN INSTANCE WHERE A PROPOSED UTILITY IS ABOVE THE EXISTING GROUND LINE OR HAS LESS THAN 3 FEET OF COVER OVER THE PROPOSED UTILITY, THE CONTRACTOR SHALL PLACE AND COMPACT THE FUTURE FILL TO A POINT AT LEAST 3 FEET ABOVE THE TOP OF THE PROPOSED UTILITY. ONCE THIS LEVEL IS REACHED, THE CONTRACTOR MAY TRENCH IN THE UTILITY AND BACKFILL PRIOR TO PROCEEDING WITH THE REMAINING EARTHEN COMPACTED EMBANKMENT FILL.
- 24. ALL STORM SEWERS AND WATER LINES UNDER THE PAVEMENT SHALL BE BACKFILLED WITH FLOWABLE FILL IN ACCORDANCE WITH THE DETAILS SHOWN ON PLANS.
- 25. LABOR, TOOLS, MATERIALS, AND EQUIPMENT REQUIRED TO TEMPORARILY PLUG OR BLOCK THE END OF PROPOSED STORM SEWER PIPE TO PREVENT BACKFILL MATERIAL FROM ENTERING SHALL BE SUBSIDIARY TO BID ITEM 15" STORM.
- 26. ALL DISTURBED AREAS THAT ARE TO BE SEEDED OR PLANTED SHALL BE MULCHED IN ACCORDANCE WITH THE **TECHNICAL SPECIFICATIONS.**
- 27. FOR SIDEWALKS, ALL EXPOSED EDGES AND JOINT EDGES SHALL BE ROUNDED WITH AN EDGING TOOL HAVING A RADIUS OF 3/8 INCH. UNLESS APPROVED BY THE ENGINEER. ALL JOINTS SHALL BE FORMED BY MAKING A 1/4-INCH GROOVE 2 INCHES DEEP WHILE THE CONCRETE IS STILL PLASTIC ENOUGH TO BE WORKED BUT HARD ENOUGH SO IT WILL NOT SLUMP AFTER GROOVING.
- 28. ALL CONCRETE MATERIALS SHALL CONFORM TO THE SPECIFICATIONS OF THE KANSAS CITY METROPOLITAN MATERIALS BOARD (KCMMB). COARSE AGGREGATES FOR ALL MIXES SHALL BE ENTIRELY GRANITE OR QUARTZITE.
- 29. SPRINKLER HEADS AFFECTED BY CONSTRUCTION SHALL BE CAPPED FOR THE DURATION OF CONSTRUCTION AND THE HEADS REPLACED AT THE COMPLETION OF CONSTRUCTION. ANY SPRINKLER APPURTENANCES OR LINES DAMAGED DURING CONSTRUCTION SHALL BE REPLACED AND SHALL BE SUBSIDIARY TO THE BID ITEM SOD.
- 30. THE USE OF DUAL WALL (LESS THAN 30") AND TRIPLE WALL (30" TO 60") HIGH-PERFORMANCE POLYPROPYLENE PIPE (PP), MEETING THE REQUIREMENTS OF MODOT SPECIFICADTION SECTION 724 FOR CROSSROAD PIPES IN LIEU OF RCP IS ACCEPTABLE. PROVIDED THAT THE PIPE IS BEDDED PROPERLY PER MANUFACTURER'S RECOMMENDATION AND THE TRENCH IS BACKFILLED WITH FLOWABLE FILL UP TO THE SUBGRADE OF THE PAVEMENT.
- 31. FOR TRAFFIC MANAGEMENT PURPOSES SHIFT CHANGES AT KAWASAKI MARYVILLE PLANT ARE AS FOLLOWS: MORNING SHIFT CHANGE: 6:30 AM TO 7:30 AM AFTERNOON SHIFT CHANGE: 2:30 PM TO 3:30 PM
  - NIGHT SHIFT CHANGE: 10:30 PM TO 11:30 PM

		Landscape Architect Doug Pickert		REV. NO.	DATE	DESCRIPTION
		Indigo Design			05/02/2025	ADDENDUM #1
		8593 Timber Trails Drive De Soto, KS 66018 Tel: (913) 583-1370				
	SK Design Group, Inc.	Electrical Engineer	Survey			
-	4600 College Boulevard, Suite 100	Kathi Vandel Lightworks, Inc.	Adam Teel Midland Surveying, Inc.			
2.0 -/	Overland Park, Kansas 66211 913-451-1818	3618 Main Weston, MO 64098	501 North. Market Maryville, MO 64468			
;	http://www.skdg.com	Tel: (816) 640-9948	Tel: (660) 582-8633			

### **GENERAL WATER NOTES:**

- TAPERED BRASS PLUGS.
- DISCRETION OF THE CITY OF MARYVILLE.

- **INFORMATION FROM UTILITY COMPANIES.**
- SEWER LINE.

WHENEVER A WATER MAIN MUST CROSS ABOVE A SEWER. A VERTICAL SEPARATION OF 18 INCHES BETWEEN THE BOTTOM OF THE WATER MAIN AND THE TOP OF THE SEWER SHALL BE MAINTAINED. A FULL LENGTH OF WATER MAIN PIPE SHALL BE CENTERED ON THE SEWER TO BE CROSSED SO THAT THE JOINTS WILL BE EQUALLY DISTANT FROM THE SEWER AND AS FAR AWAY AS POSSIBLE. THE 18-INCH VERTICAL SEPARATION SHALL BE MAINTAINED FOR THAT PORTION OF THE WATER MAIN LOCATED WITHIN 10 FEET, HORIZONTALLY, OF ANY SEWER IT CROSSES.

WHEN IT IS IMPOSSIBLE TO OBTAIN PROPER HORIZONTAL SEPARATION AS STIPULATED ABOVE, OR WHEN A WATER MAIN MUST CROSS UNDER A SEWER. THE SEWER MUST BE RECONSTRUCTED OF DUCTILE IRON PIPE, PRE-STRESSED CONCRETE CYLINDER PIPE, OR PVC PRESSURE PIPE CONFORMING TO CITY STANDARDS & SPECIFICATIONS. ALL SHALL BE PRESSURE TESTED TO ASSURE WATER TIGHTNESS BEFORE BACKFILLING. THE REQUIRED LENGTH OF SEWER TO BE REPLACED OR CONSTRUCTED OF PRESSURE PIPE WILL BE THE LENGTH NECESSARY TO ACHIEVE 10 FEET HORIZONTAL SEPARATION

- SEDIMENT CONTROL SPECIFICATIONS.

ALL WORK SHALL BE DONE IN ACCORDANCE WITH THE MOST RECENT VERSION OF THE STANDARDS AND SPECIFICATIONS FOR WATER MAIN EXTENSIONS AND RELOCATIONS OF THE MARYVILLE, **MISSOURI WATER SERVICES DEPARTMENT.** 

2. CONTRACTOR SHALL POTHOLE AND EXPOSE ALL TIE-IN AND CROSSING LOCATIONS. THE CONTRACTOR SHALL FURNISH AND INSTALL ALL FITTINGS REQUIRED TO PROVIDE PROPER HORIZONTAL AND VERTICAL ALIGNMENT FOR NEW WATER MAINS, CONNECTIONS TO EXISTING WATER MAINS AND INSTALLATION OF FIRE HYDRANTS AT THE PROPER LOCATION AND ELEVATION, WHETHER OR NOT THE PROPER FITTINGS. LOCATION OR ELEVATIONS ARE CALLED OUT ON THE DRAWINGS, INCLUDING MODIFICATION OF EXISTING INFRASTRUCTURE REQUIRED TO MAKE ALL OF THE WORK CONFORM TO THE CURRENT STANDARDS AND SPECIFICATIONS FOR WATER MAIN EXTENSIONS AND RELOCATIONS OF THE MARYVILLE, MISSOURI WATER SERVICES DEPARTMENT.

3. THE CONTRACTOR SHALL FURNISH AND INSTALL ALL TEMPORARY BLOW-OFF ASSEMBLIES, FITTINGS, THRUST BLOCKING, AND RESTRAINING DEVICES REQUIRED FOR TEMPORARY CONNECTIONS FOR FLUSHING, PRESSURE TESTING, CHLORINATION, AND DE-CHLORINATION OF THE NEW WATER MAINS. PRIOR TO PLACING NEW MAINS IN SERVICE THE CONTRACTOR SHALL REMOVE ANY CORPORATION COCKS USED FOR TESTING OR CHLORINATION AND REPLACE THEM WITH

4. SCHEDULING OF WATER MAIN SHUTS AND CONNECTION TO EXISTING MAINS SHALL BE AT THE

5. ALL FIRE HYDRANT BRANCHES SHALL BE RESTRAINED USING APPROVED RESTRAINING DEVICES. HYDRANTS SHALL BE INSTALLED SO THAT THE CENTERLINE OF THE OUTLET NOZZLE IS BETWEEN EIGHTEEN AND TWENTY-ONE INCHES (18" - 21") ABOVE FINISHED GRADE, AND SO THAT THERE IS A MINIMUM CLEAR AREA OF 5' IN EACH DIRECTION TO ALLOW OPERATION OF THE HYDRANT.

6. THE LOCATIONS OF EXISTING UTILITIES, AS SHOWN, ARE APPROXIMATE. IT SHALL BE THE **RESPONSIBILITY OF THE CONTRACTOR TO VERIFY THE LOCATIONS AND ELEVATIONS OF ALL** EXISTING UTILITIES. CONTRACTORS SHALL POTHOLE AND EXPOSE ALL UTILITIES (INDICATED ON THE DRAWINGS, LOCATED AT GRADE BY A UTILITY LOCATING SERVICE, OR EVIDENT FROM UTILITY COMPANY INFORMATION) AT LEAST 500 FEET IN ADVANCE OF WATER MAIN CONSTRUCTION, DETERMINING THE DEPTH, SIZE, AND MATERIAL OF THE UTILITIES IN PROXIMITY TO THE PROPOSED WATER MAIN ALIGNMENT. CONTRACTOR SHALL PROVIDE THIS INFORMATION TO THE ENGINEER & ADVISE OF ANY POTENTIAL CONFLICTS WITH THE PROPOSED PIPELINE ALIGNMENT. DEFLECT PIPE TO MAINTAIN MINIMUM 5 FEET HORIZONTAL AND 18 INCH VERTICAL CLEARANCES BETWEEN PROPOSED WATER MAIN AND ALL EXISTING UTILITIES.

7. THE CONTRACTOR SHALL COMPLY WITH STATE LAW REQUIRING ANY PERSON OR FIRM DOING EXCAVATION ON THE PUBLIC RIGHT-OF-WAY DO SO ONLY AFTER GIVING NOTICE TO AND OBTAINING

8. STREETS AND PARKING AREAS ARE TO BE TO GRADED AND CURBS IN PLACE PRIOR TO CONSTRUCTION OF WATER MAINS. WATER MAINS SHALL BE INSTALLED WITH A MINIMUM GROUND COVER OF 42 INCHES BELOW FINISHED GRADE. SIXTEEN (16)-INCH AND LARGER WATER MAINS SHALL BE INSTALLED WITH A MINIMUM GROUND COVER OF 60 INCHES BELOW FINISHED GRADE.

9. WATER MAINS SHALL BE LAID AT LEAST 10 FEET, HORIZONTALLY FROM ANY SEWER. WHEN LOCAL CONDITIONS PREVENT A HORIZONTAL SEPARATION OF 10 FEET, A WATER MAIN MAY BE LAID CLOSER THAN 10 FEET TO A SEWER, PROVIDED THAT THE WATER MAIN IS LAID IN A SEPARATE TRENCH, OR ON AN UNDISTURBED EARTH SHELF LOCATED ON ONE SIDE OF THE SEWER, AT SUCH AN ELEVATION THAT THE BOTTOM OF THE WATER MAIN IS AT LEAST 18 INCHES ABOVE THE TOP OF THE SEWER. WATER MAINS SHALL BE LAID SUCH THAT THERE IS A MINIMUM OF 18 INCHES CLEARANCE BETWEEN THE PIPE WALL AND THE EXTERIOR OF ANY MANHOLE AND/OR INLET ON THE

10. ALL WORK SHALL CONFORM TO THE LATEST REVISION OF THE MARYVILLE, MISSOURI EROSION AND

11. THE END OF ALL ABANDONED WATER MAINS SHALL BE PLUGGED WITH CONCRETE.

12. COVERS, LIDS, AND STANDPIPES ON ALL ABANDONED VALVES SHALL BE REMOVED TO AT LEAST TWO FEET (2') BELOW GRADE AND THE AREA SHALL BE PROPERLY BACKFILLED. IN PAVED AREAS REMOVAL OF VALVE LID AND FILLING OF VALVE BOX WITH CONCRETE MAY BE ALLOWED.

13. EXISTING FIRE HYDRANTS THAT ARE REMOVED SHALL BE RETURNED TO THE CITY OF MARYVILLE.

14. WATER SERVICE LINES CONNECTED TO MAINS BEING ABANDONED SHALL BE RECONNECTED TO NEW MAINS, UNLESS SHOWN OTHERWISE. EXISTING WATER SERVICE LINES BEING TRANSFERRED TO NEW MAINS WILL BE UPGRADED TO MEET CURRENT REGULATIONS.

15. THE CONTRACTOR SHALL VERIFY THE OUTSIDE DIAMETER (O.D.) OF THE EXISTING WATER MAIN PRIOR TO SCHEDULING CONNECTION. PROVIDE SOLID SLEEVES AS REQUIRED.

16. CONTRACTORS SHALL PROTECT EXISTING POWER POLES AND LIGHT POLES FROM DAMAGE AND SHALL PROVIDE BRACING, SHORING, OR OTHER WORK NECESSARY FOR SUCH PROTECTION. ANY STRUCTURES REMOVED DURING CONSTRUCTION OPERATIONS SHALL BE REPLACED.


### GENERAL SEQUENCE OF WORK BY THE CONTRACTOR (UNLESS NOTED **OTHERWISE**):

1. CONTRACTOR SHALL DIVIDE THE CONSTRUCTION INTO MANAGEABLE SECTIONS FOR UTILITIES, BASE CONSTRUCTION, AND PAVING OPERATIONS TO MINIMIZE DISRUPTIONS OF TRAFFIC.

- 2. CONTRACTOR SHALL MAINTAIN ACCESS TO ALL PROPERTIES AT ALL TIMES. 3. SUBMIT DETAILED SCHEDULE, CONSTRUCTION PHASING, AND TRAFFIC CONTROL PLANS FOR APPROVAL BY OWNER AND ENGINEER.
- 4. PERFORM SURVEY AND STAKING OF IMPROVEMENTS
- **5. INSTALL EROSION CONTROL MEASURES**
- 6. PERFORM GENERAL DEMOLITION AND GRADING ACCORDING TO THE APPROVED SCHEDULE. 7. INSTALL NEW STORM SYSTEM ACCORDING TO THE APPROVED SCHEDULE AND MAINTAIN ACCESS TO ALL PROPERTIES.
- 8. INSTALL WATERLINES
- 9. COORDINATE GAS AND TELECOM RELOCATIONS WITH THE GAS AND TELECOM COMPANIES AND ESTABLISH ROUTING.
- 10. STAKE ALIGNMENT OF GAS AND TELECOM LINES AND IDENTIFY PROPOSED UTILITY CROSSING DEPTHS FOR THE GAS AND TELECOM COMPANIES TO AVOID CONFLICTS.
- 11. GAS AND TELECOM COMPANIES TO PERFORM THEIR RELOCATIONS
- 12. ESTABLISH THE ALIGNMENT OF THE POWER LINE CONDUITS AND EQUIPMENT PAD LOCATIONS WITH EVERGY. COORDINATE CONDUIT ALIGNMENT AND LOCATION OF PADS WITH OTHER IMPROVEMENTS 13. STAKE ALL PROPOSED STORM AND WATERLINE CROSSINGS AND MONUMENT SIGN LOCATIONS AT THE POWER CONDUITS TO AVOID CONFLICTS
- 14. INSTALL POWER CONDUITS WITH TRACE WIRE, AND SURVEY AS BUILT ALIGNMENT OF THE CONDUITS AT 25' ON CENTER AND AT PROPOSED UTILITY CROSSINGS. (ALTERNATE BID)
- 15. INSTALL POWER EQUIPMENT PADS. (ALTERNATE BID)
- 16. EVERGY TO INSTALL NEW EQUIPMENT AND CONDUCTORS, AND ENERGIZE SYSTEM. (ALTERNATE BID)
- 17. DEMOLITION OF EXISTING POWER SYSTEM AND OVERHEAD LINES. (ALTERNATE BID)
- 18. REFER TO SHEET SERIES C33 FOR ADDITIONAL REQUIREMENTS FOR SEQUENCING AND TRAFFIC CONTROL 19. INSTALL BASE AGGREGATE AND PAVEMENT CONCRETE BASE IN SECTIONS WHERE THE ROAD IS BEING WIDENED ACCORDING TO THE APPROVED SCHEDULE.

20. MILL PAVEMENT ACCORDING TO THE APPROVED SCHEDULE. 21. MAINTAIN ONE 11' LANE OF TRAFFIC OPEN IN EACH DIRECTION ON S. MAIN AND PROVIDE ACCESS TO ALL PROPERTIES DURING INSTALLATION OF ASPHALT PAVING. PROVIDE FLAG MAN AS NECESSARY AND SPECIFICALLY FOR WORK SOUTH OF STA. 72+00

- 22. PROVIDE WEDGE ASPHALT AS NECESSARY AT CHANGES IN GRADE FOR MAINTENANCE OF ACCESS. WEDGE ASPHALT WILL BE PAID AT THE UNIT PRICE FOR TEMPORARY PAVING.
- 23. LIGHTING INSTALLATION
- 24. PAVEMENT MARKINGS AND REGULATORY SIGNS 25. LANDSCAPING, IRRIGATION, AND MONUMENT SIGNS
- 26. WORK THAT DOES NOT AFFECT ACCESS OR THE APPROVED SCHEDULE MAY BE PERFORMED CONCURRENTLY WITH OTHER ITEMS OF WORK.
- 27. PROPOSED MODIFICATIONS TO THE GENERAL SEQUENCE OF WORK SHALL BE SUBMITTED FOR APPROVAL **GENERAL UTILITY CONSTRUCTION NOTES**
- 1. CONTRACTOR SHALL SUBMIT A DETAILED SCHEDULE FOR APPROVAL PRIOR TO START OF CONSTRUCTION.
- 2. CONTRACTOR'S SCHEDULE SHALL INCLUDE ALL CONSTRUCTION BY THE CONTRACTOR AND THE UTILITY COMPANIES.
- 3. CONTRACTOR IS RESPONSIBLE FOR COORDINATING ALL UTILITY RELOCATIONS.
- 4. CONTRACTOR IS RESPONSIBLE FOR MAINTAINING UTILITY SERVICE TO ALL PROPERTIES AND SHALL COORDINATE UTILITY SHUT OFFS WITH PROPERTY OWNERS. 5. CONTRACTOR SHALL FOLLOW THE GENERAL SEQUENCE OF WORK STATED HEREIN UNLESS APPROVED BY THE
- ENGINEER. 6. CONCURRENT ACTIVITIES MAY BE PERFORMED IF THEY ARE COORDINATED AND DO NOT AFFECT THE OVERALL
- SEQUENCE OF WORK 7. THE DEPTH OF THE PROPOSED STORM SEWERS GOVERNS OVER THE DEPTH OF OTHER UTILITIES AND SHALL BE
- CONSTRUCTED PER PLAN, UNLESS APPROVED BY THE ENGINEER. ALL OTHER UTILITIES MUST GO OVER OR UNDER THE PROPOSED STORM SEWER LINES. WHEN OTHER UTILITIES ARE CONSTRUCTED PRIOR TO STORM SEWERS, THE CONTRACTOR SHALL COORDINATE THE DEPTH OF THE UTILITY WITH THE STORM PROFILE TO AVOID CONFLICTS.
- 8. CONTRACTOR SHALL COORDINATE THE RELOCATION OF ALL EXISTING UTILITIES IN CONFLICT WITH NEW STORM. WATER AND GRADING WITH UTILITY COMPANIES.
- 9. CONTRACTOR SHALL INSTALL THE POWER CONDUITS AND EQUIPMENT PADS WHERE SHOWN ON SHEETS C29.01 THROUGH C29.02. THE EQUIPMENT LOCATIONS AND ROUTING SHOWN ARE BY EVERGY AND ARE DIAGRAMMATIC. CONTRACTOR SHALL COORDINATE CONDUIT ROUTING AND EQUIPMENT PLACEMENT WITH EXISTING AND PROPOSED IMPROVEMENTS. COORDINATE ALL WORK WITH EVERGY.
- 10. CONTRACTOR SHALL COORDINATE THE ELEVATION OF THE EQUIPMENT PADS WITH THE PROPOSED GRADES AND SHALL INSTALL PADS PER EVERGY STANDARD DETAILS, WHERE SHOWN. (ALTERNATE BID) 11. CONTRACTOR SHALL COORDINATE THE RELOCATION OF THE GAS AND TELECOM LINES WITH THE GAS AND TELECOM COMPANIES AND IDENTIFY THE ROUTING FOR THEIR LINES.
- 12. CONTRACTOR SHALL STAKE THE PROPOSED GAS AND TELECOM ROUTES, THE LOCATION OF THE PROPOSED STORM SEWER CROSSINGS. THE TOP AND BOTTOM OF THE STORM PIPE. AND THE PROPOSED GRADE. AT THE CROSSING TO ENSURE THAT STORM CROSSINGS AND FINISH GRADES ARE TAKEN INTO ACCOUNT IN THE PROFILE OF THE RELOCATED GAS AND TELECOM LINES. A MINIMUM OF 18" OF SEPARATION SHALL BE PROVIDED BETWEEN THE STORM PIPE AND THE PROPOSED GAS AND TELECOM LINES, TO ALLOW CONSTRUCTION OF THE STORM LINE WITHOUT CONFLICT WITH THE GAS AND TELECOM LINES.
- 13. CONTRACTOR SHALL COORDINATE THE DEPTH OF THE GAS LINE AND TELECOM LINES WHERE EXISTING GRADE IS BEING CUT AND STAKE THOSE AREAS TO ENSURE THAT THE GAS AND TELECOM LINES ARE INSTALLED BELOW **PROPOSED GRADES AND AVOID STORM LINES.**
- 14. CONTRACTOR SHALL COORDINATE THE LOCATION AND ELEVATION OF ALL EQUIPMENT PADS. VAULTS. HANDHOLES. RISERS, ETC. THAT ARE INSTALLED BY THE CONTRACTOR OR THE UTILITY COMPANIES, WITH THE PROPOSED IMPROVEMENTS TO ENSURE THAT PROPOSED LOCATION DOES NOT CONFLICT WITH THE SIDEWALKS. CURBS AND OTHER UTILITIES, AND ARE SET AT THE PROPER GRADE.
- 15. DIRECTIONAL BORING IS ENCOURAGED WHERE APPROPRIATE TO INSTALL THE GAS, TELECOM, AND POWER LINES WHERE POSSIBLE AND ALLOWED BY THE UTILITY COMPANY. VERTICAL PROFILE MUST AVOID THE PROPOSED STORM SEWER AND WATER LINE PROFILES
- 16. CONTRACTOR SHALL COORDINATE THE TIMING OF POWER LINE AND POWER EQUIPMENT INSTALLATION WITH EVERGY.
- 17. STORM SEWERS AND WATERLINES SHALL BE CONSTRUCTED AS DETAILED. ALL STORM SEWERS AND WATERLINE TRENCHES UNDER THE PAVING SHALL BE BACKFILLED WITH FLOWABLE FILL.

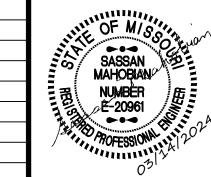


South Main Improvement Phase II & Pedestrian Enhancement STP-4301104 & TAP-4301106 City of Maryville, Missouri

**Issued for: BID SET** 

SK Project No. 16-108


Design: KM


Checked: SM

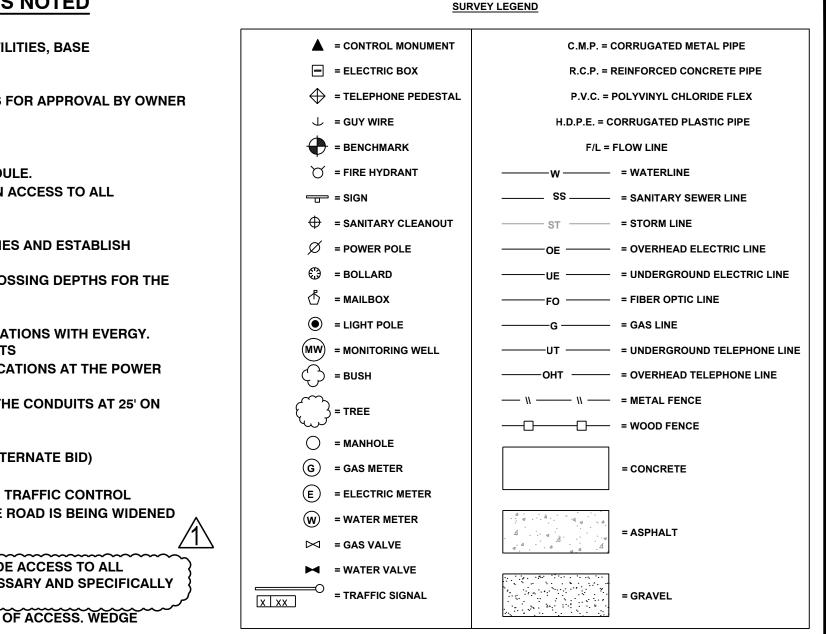


# **GENERAL NOTES**

Date: 2024-03-14

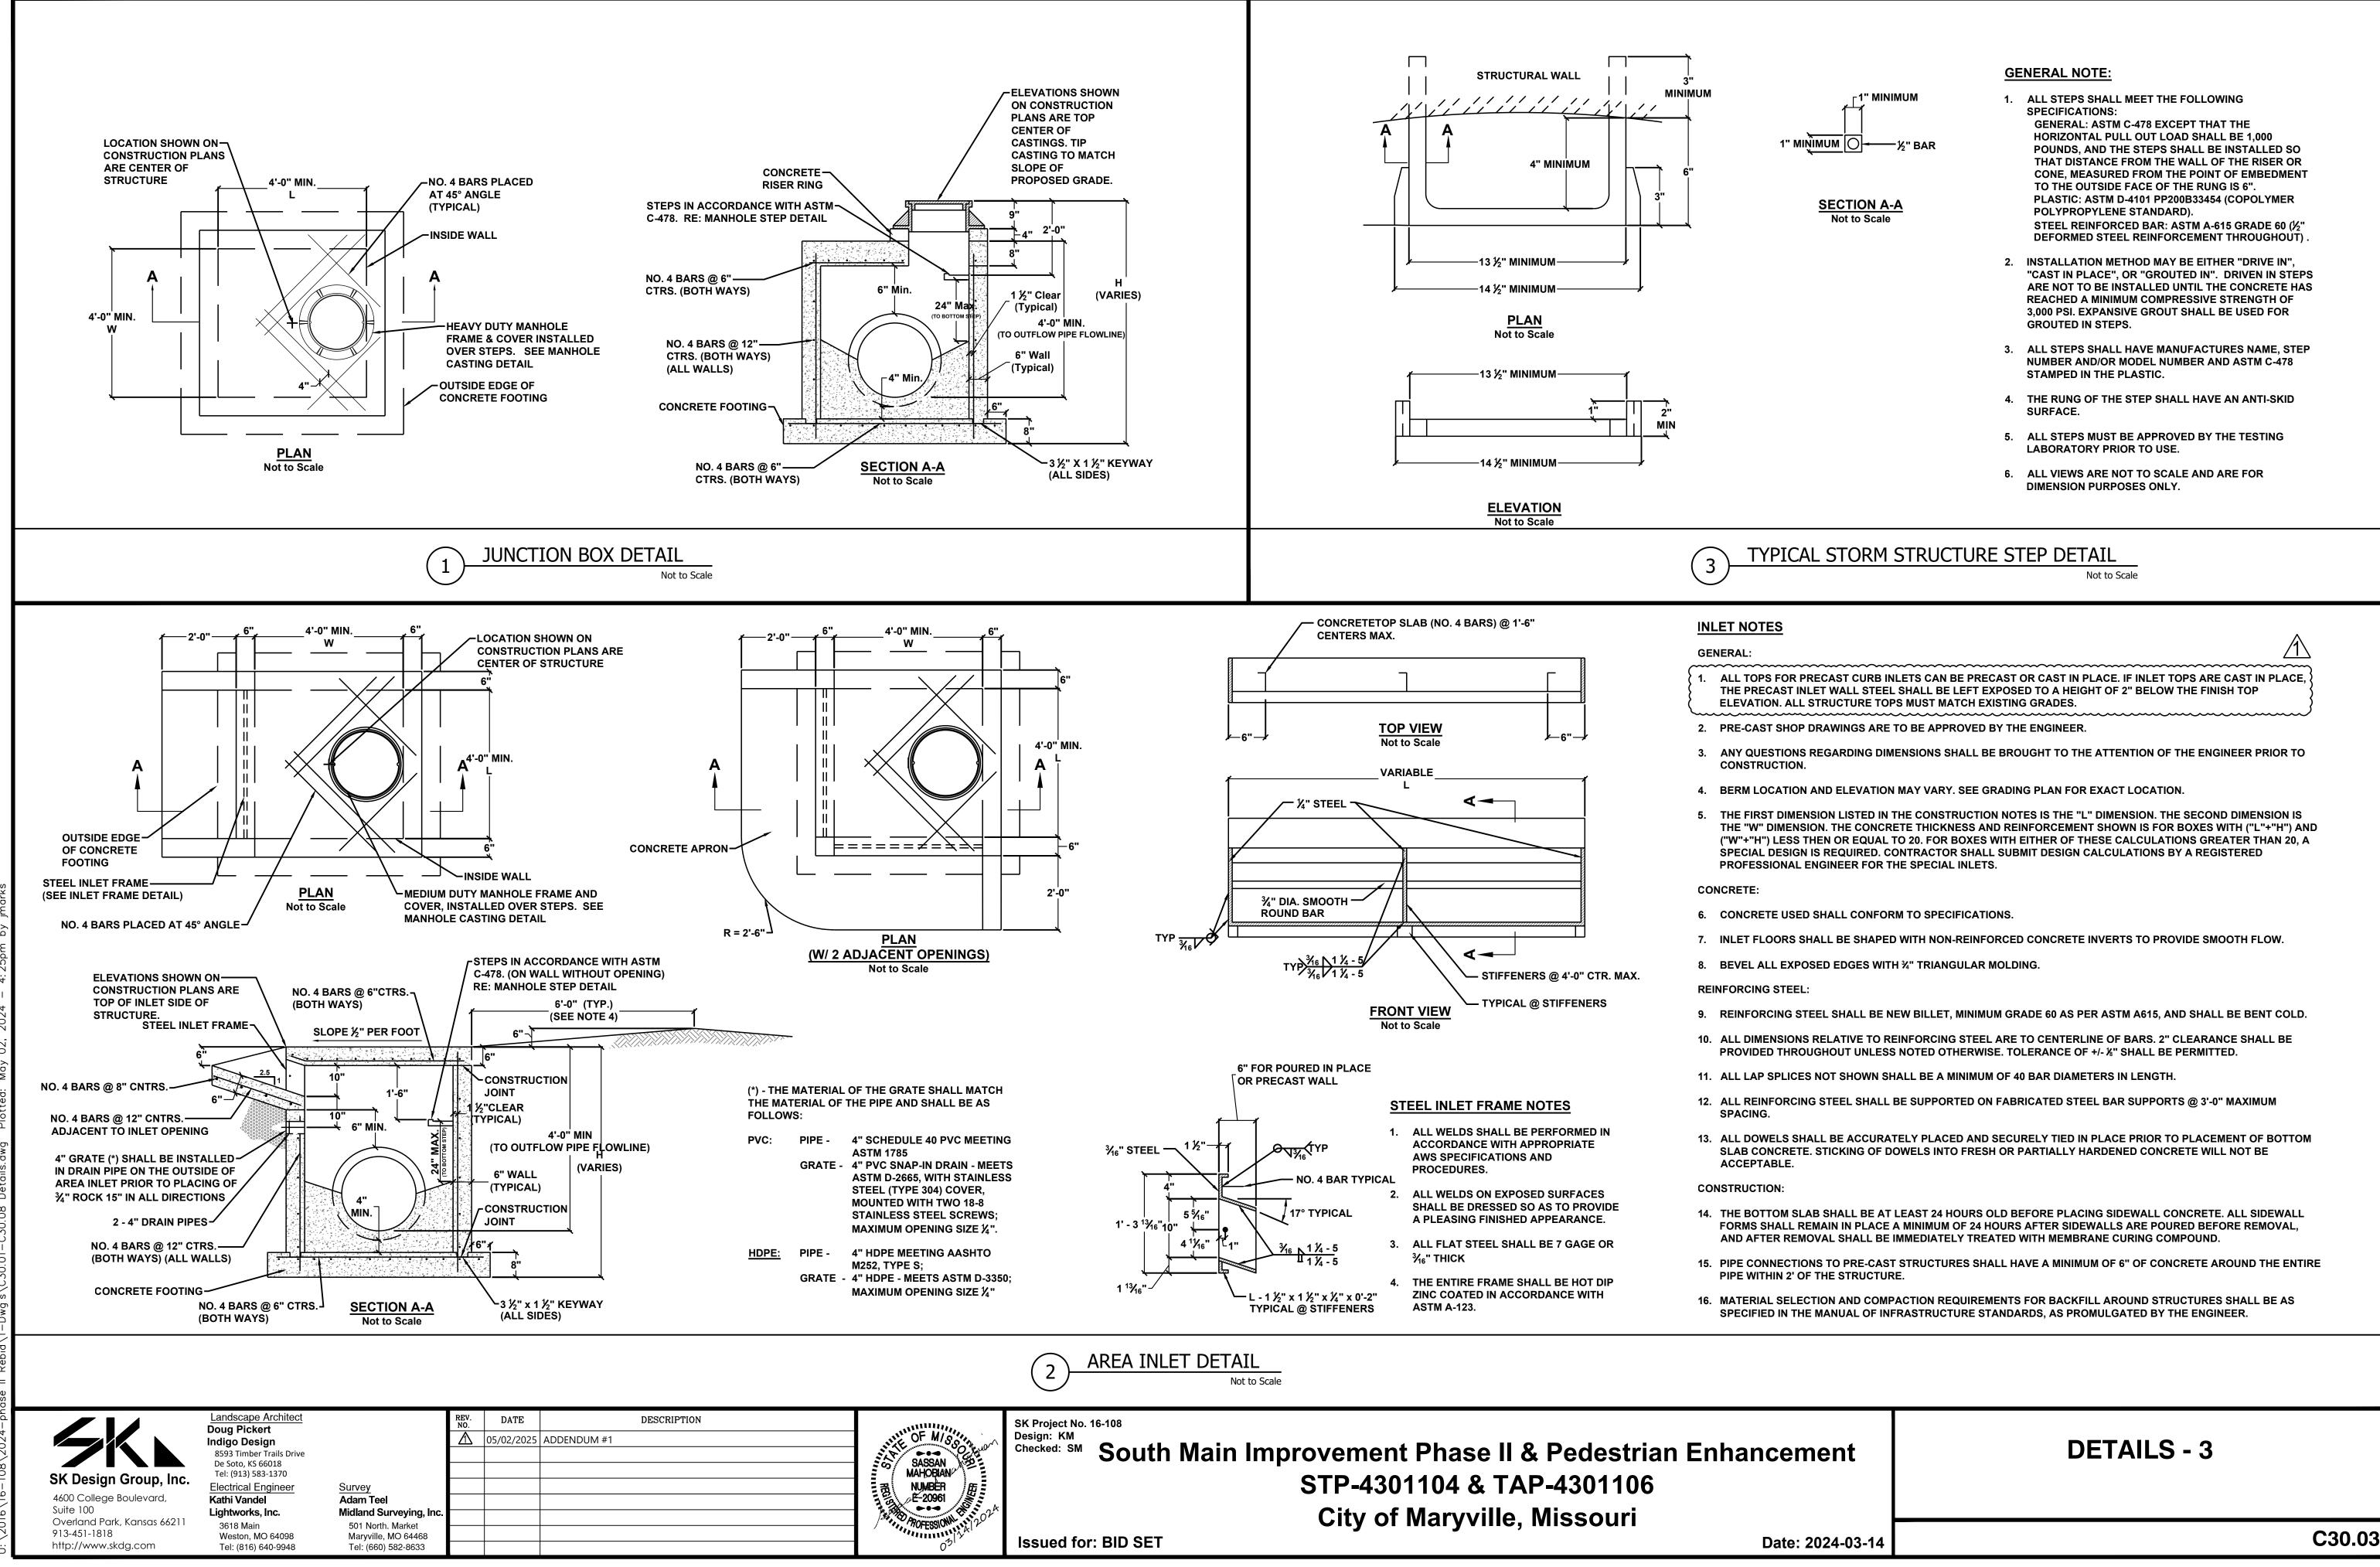


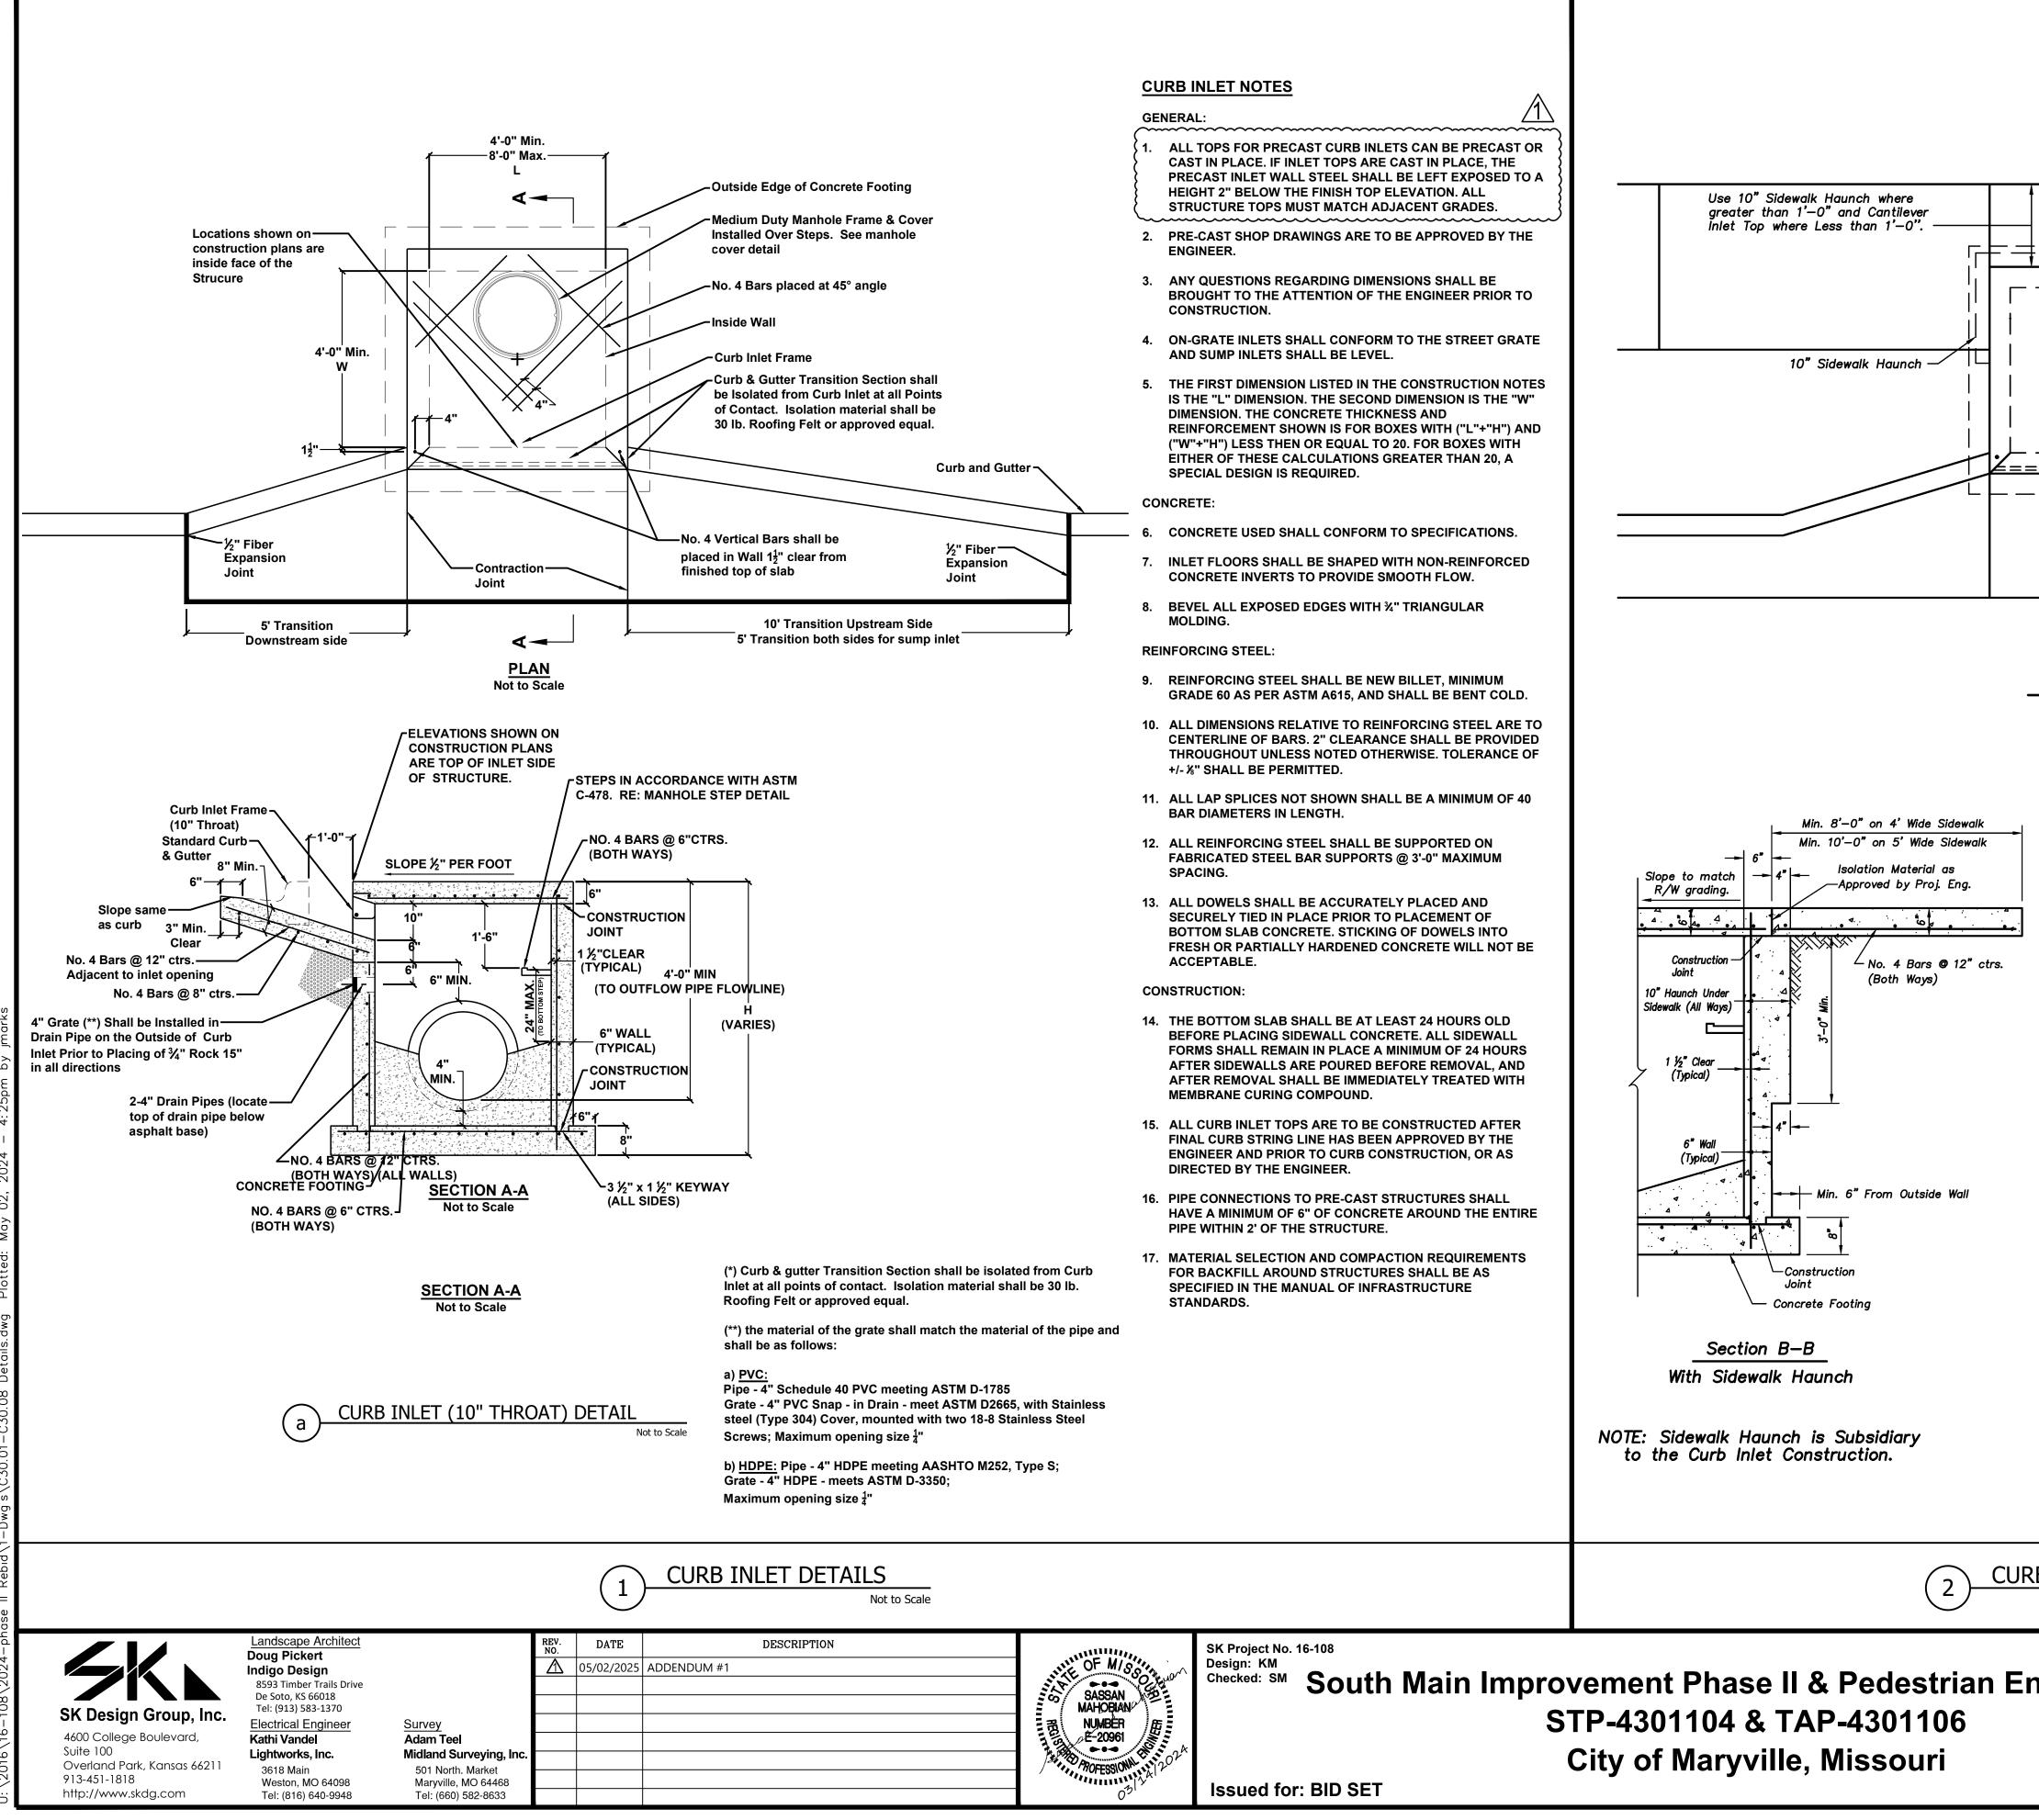

South Main Improvement Phase II & Pedestrian Enhar

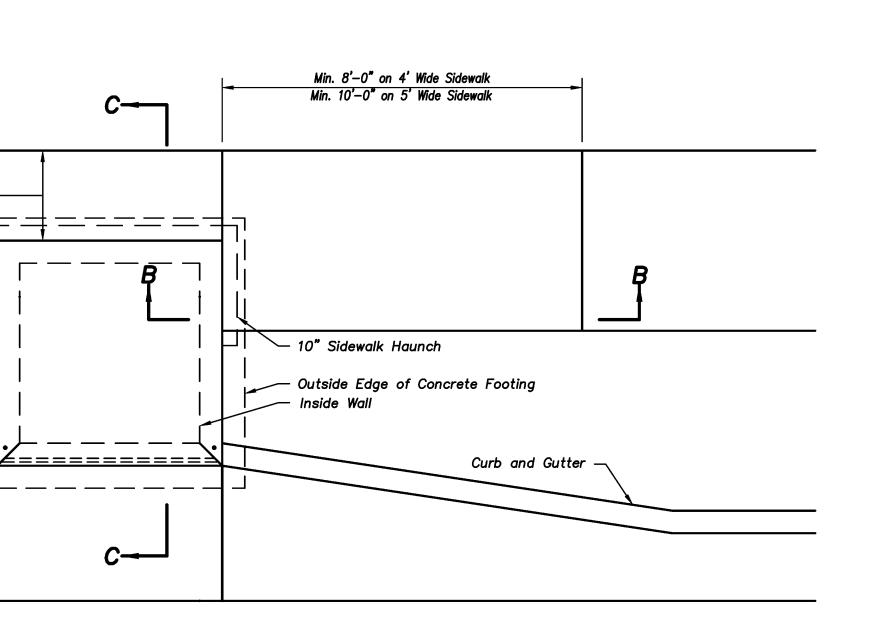


Plan

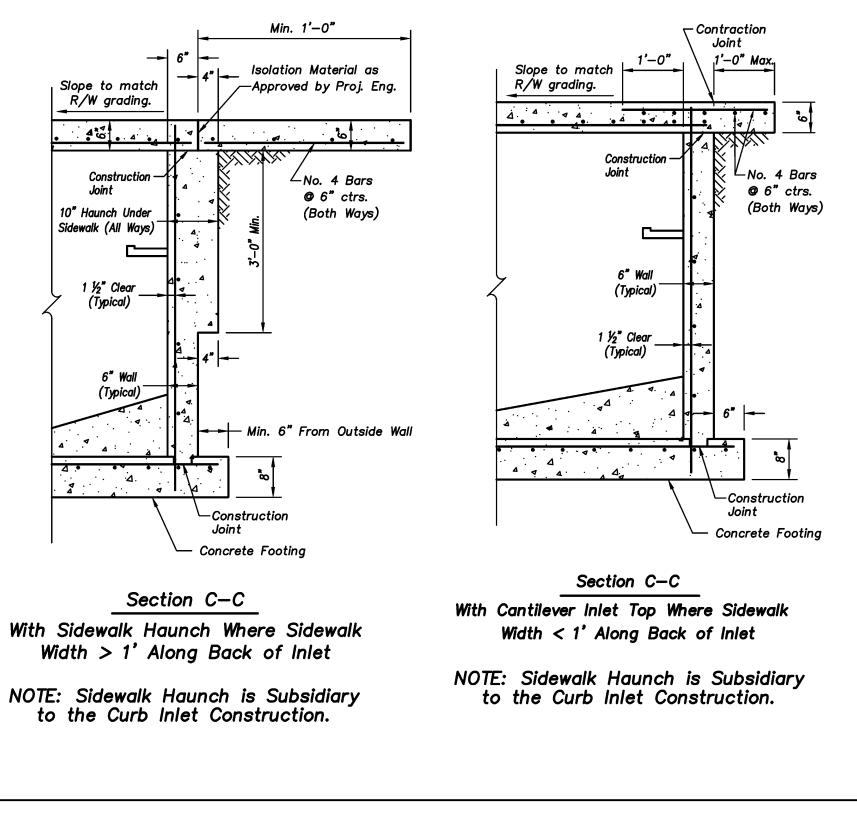


# CURB INLET WITH ADJOINING SIDEWALK DETAIL

Not to Scale


4
C30.04

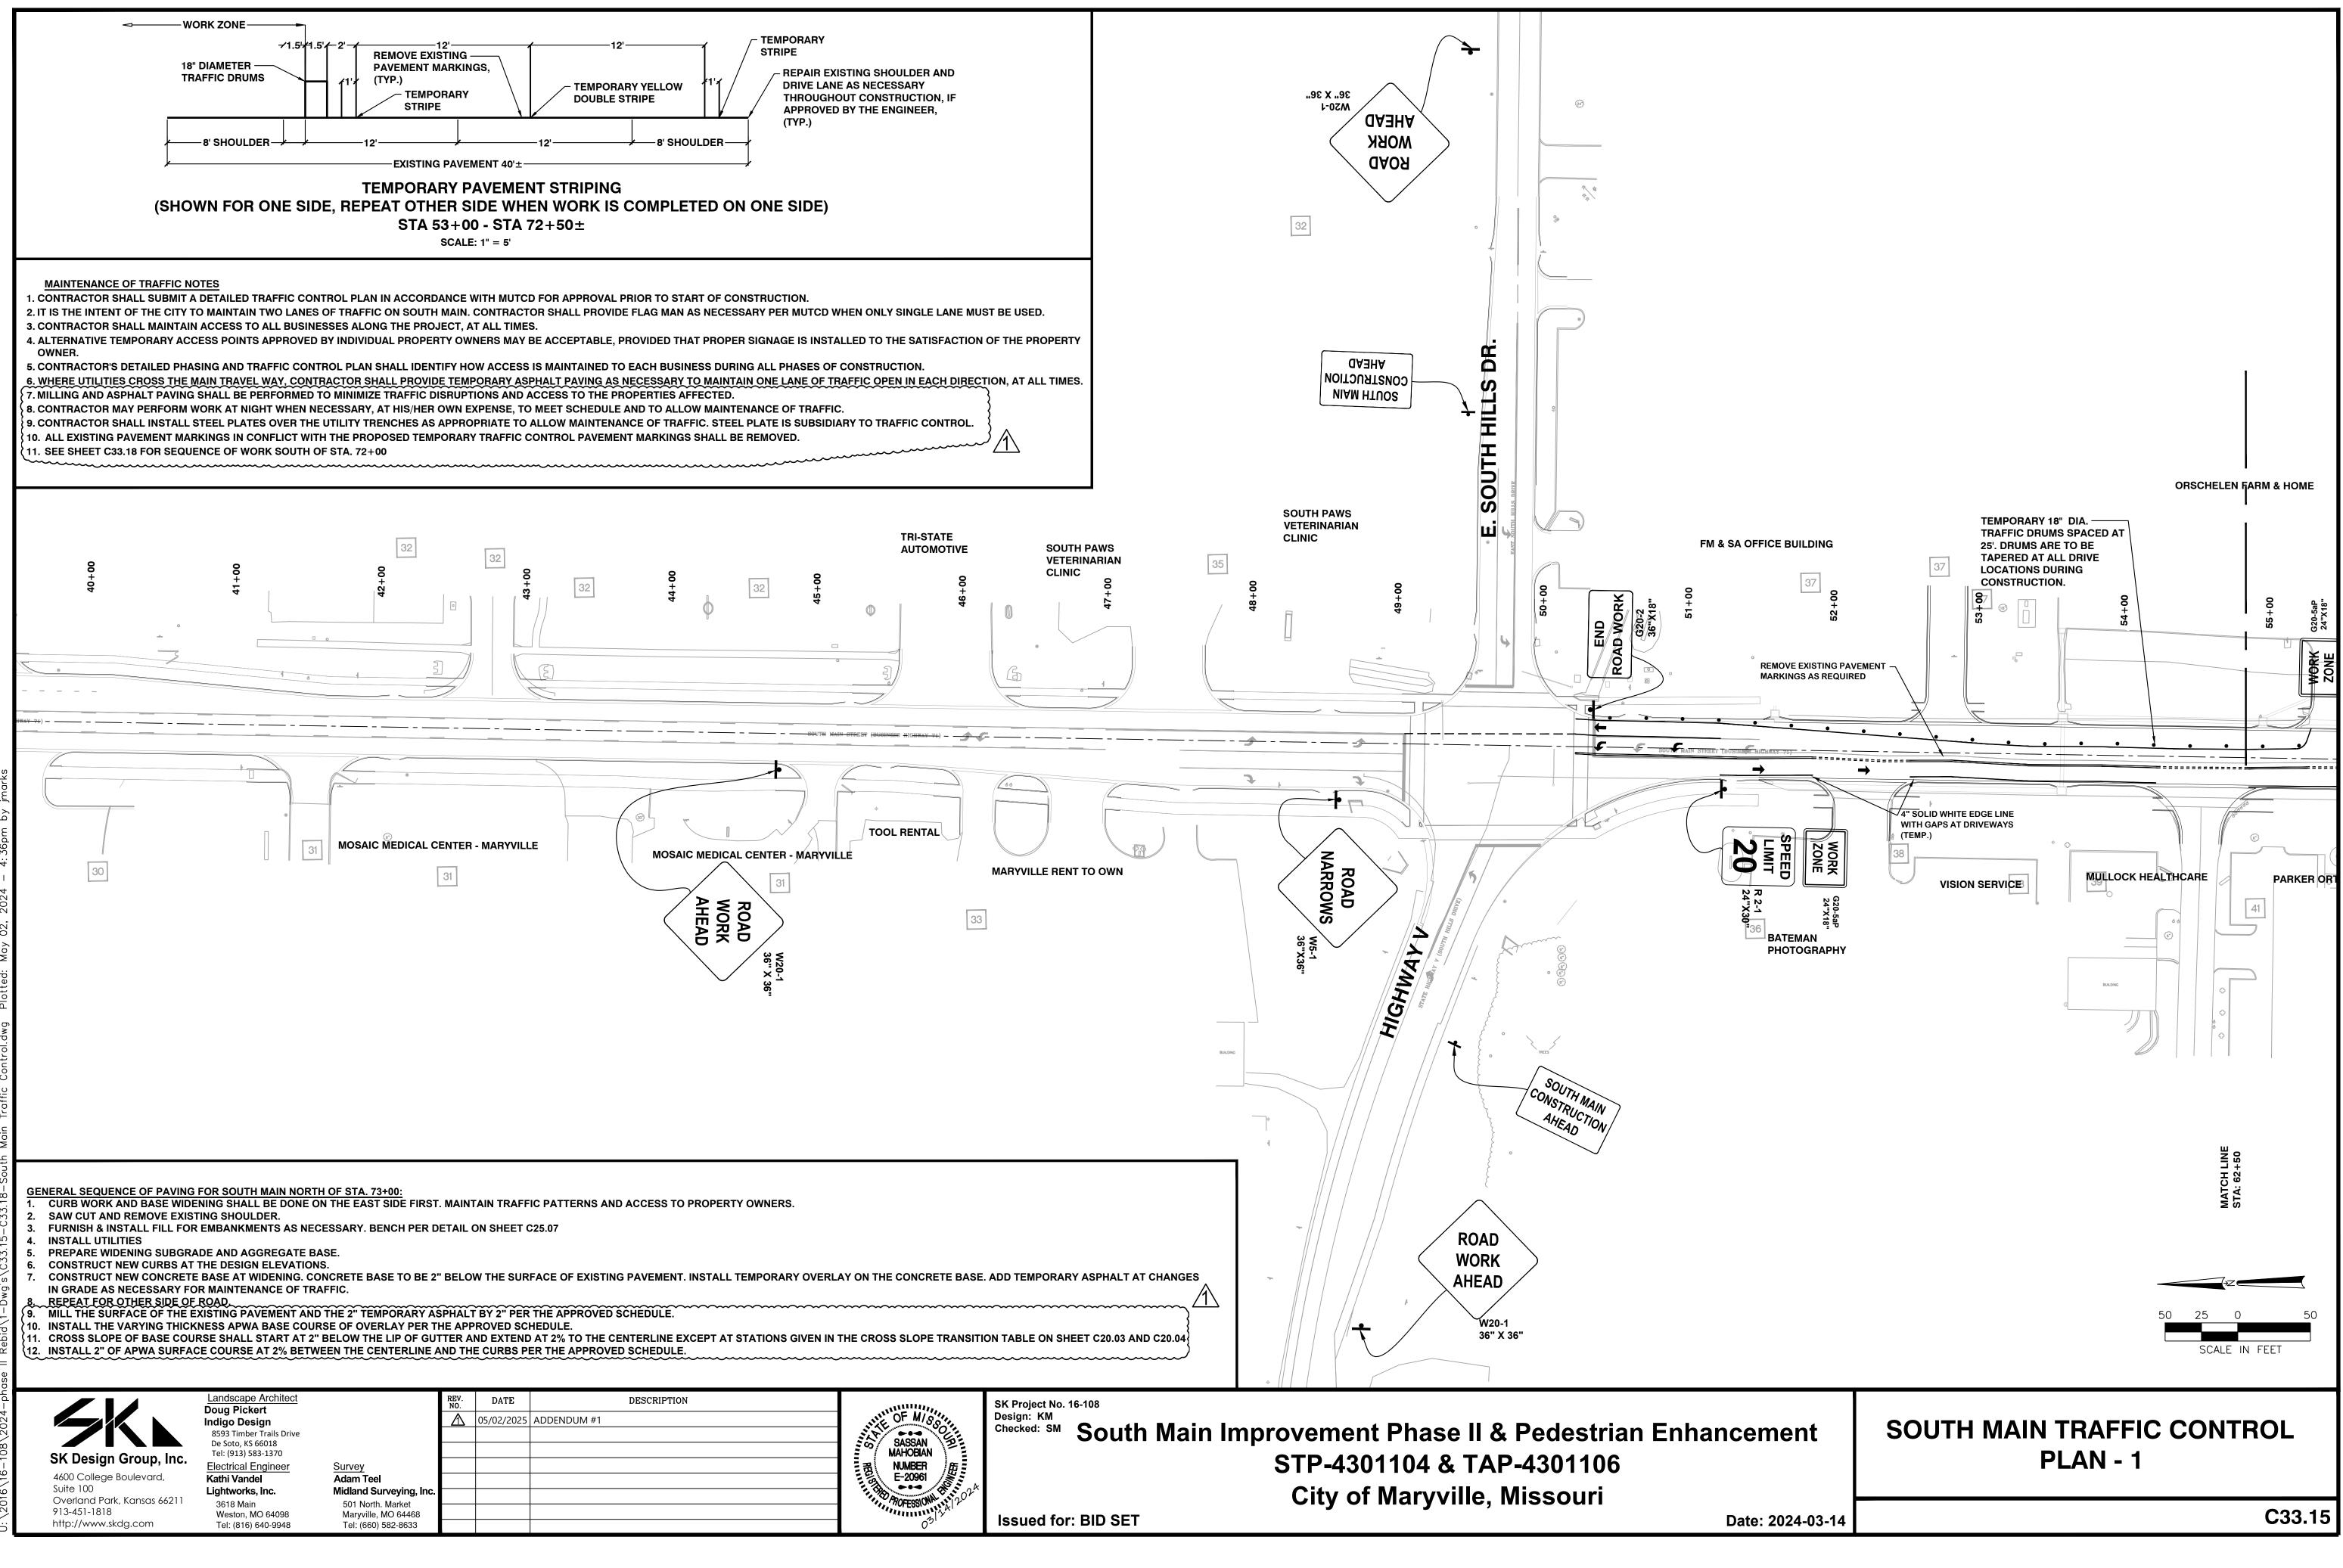


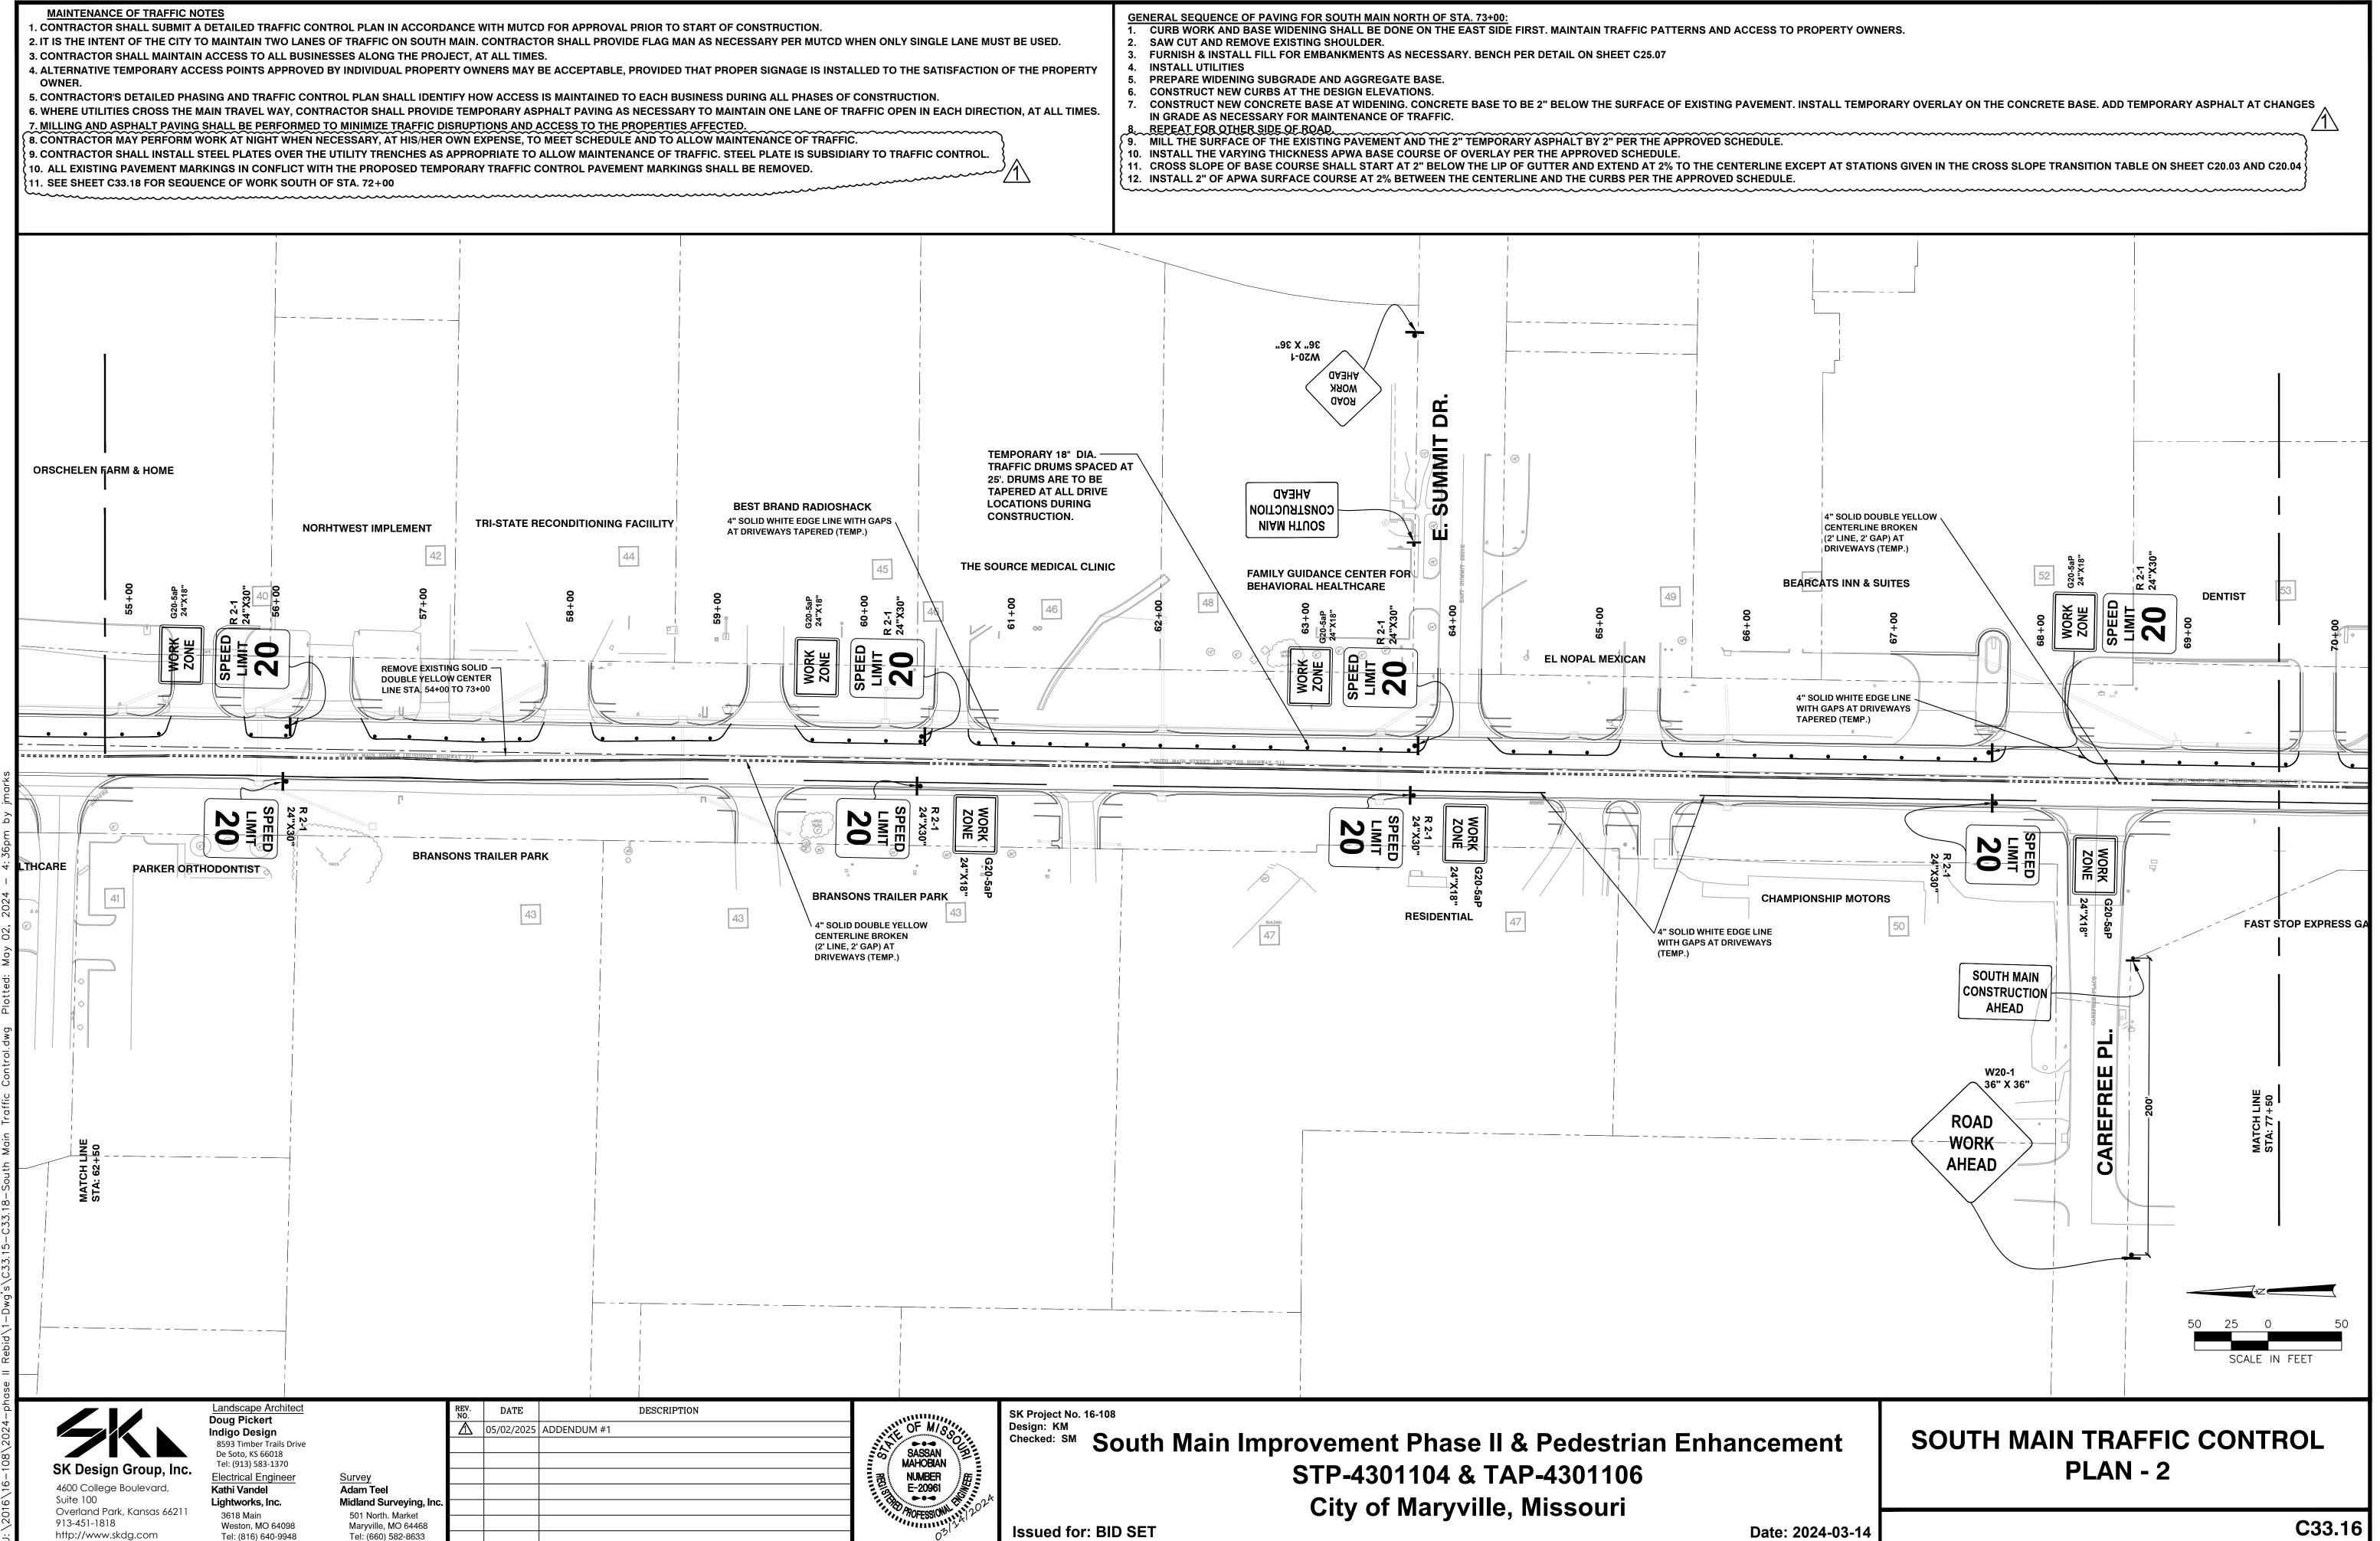

Issued for: BID SET

Date: 2024-03-14

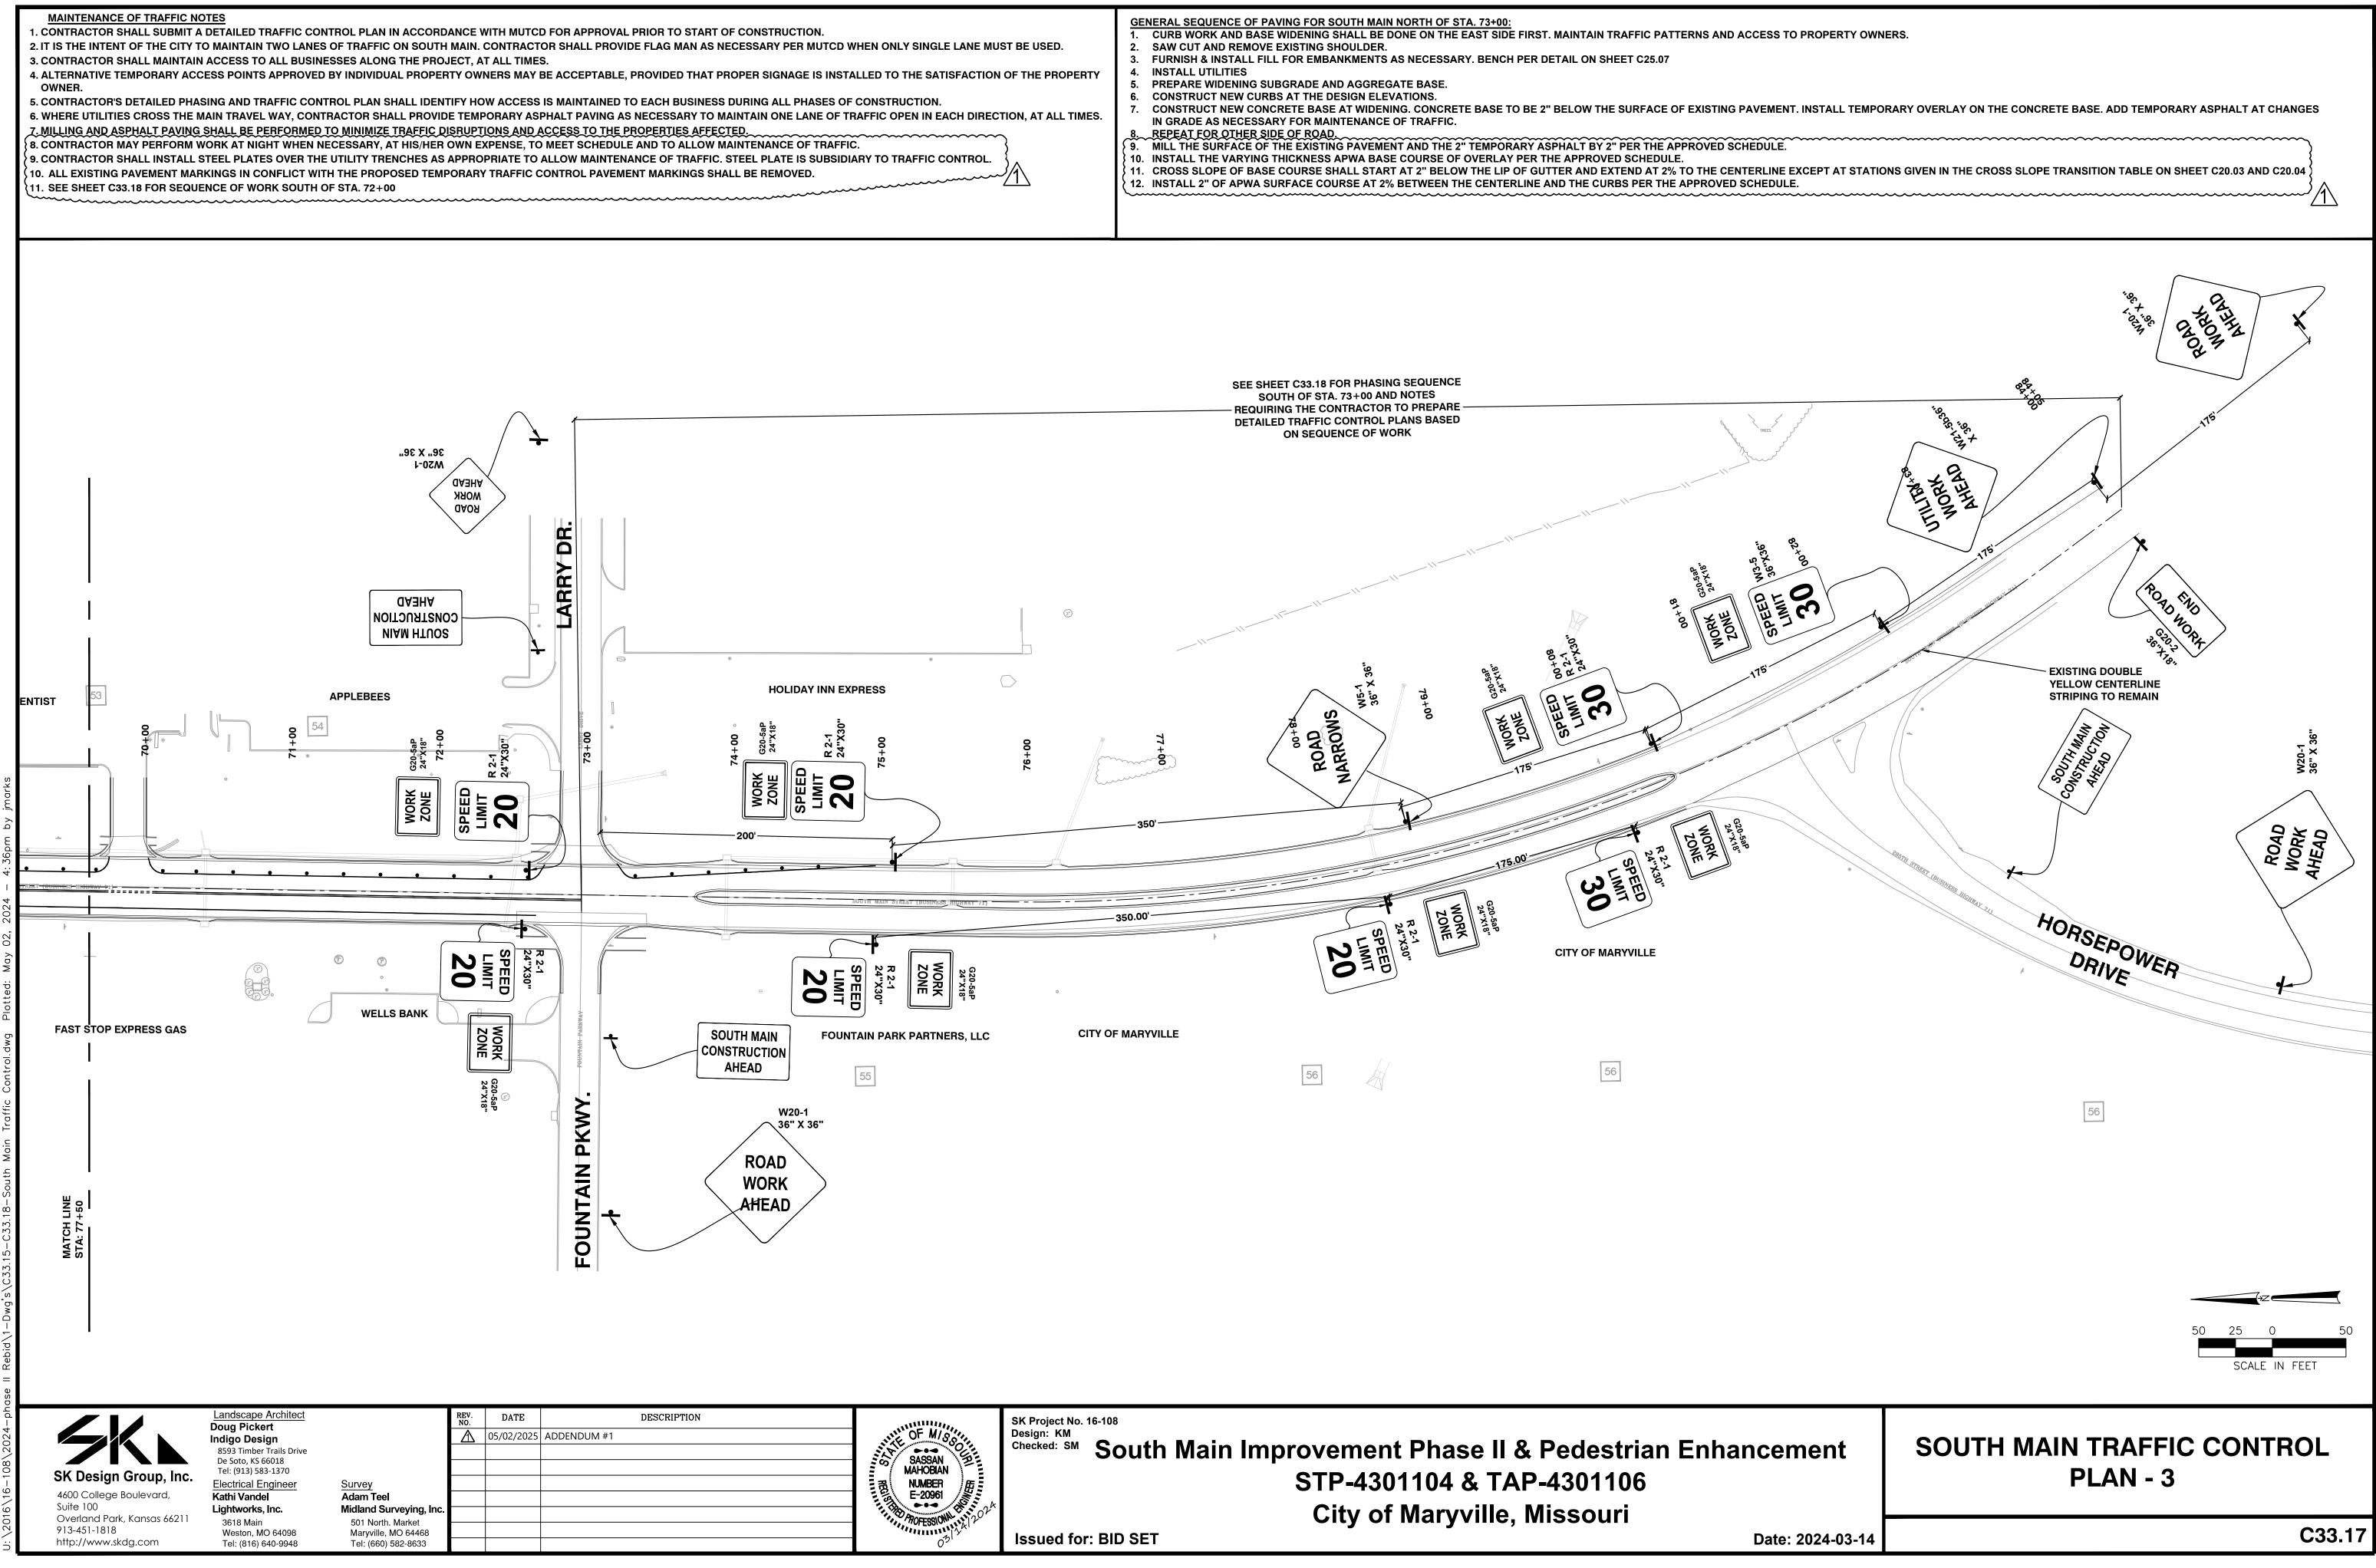

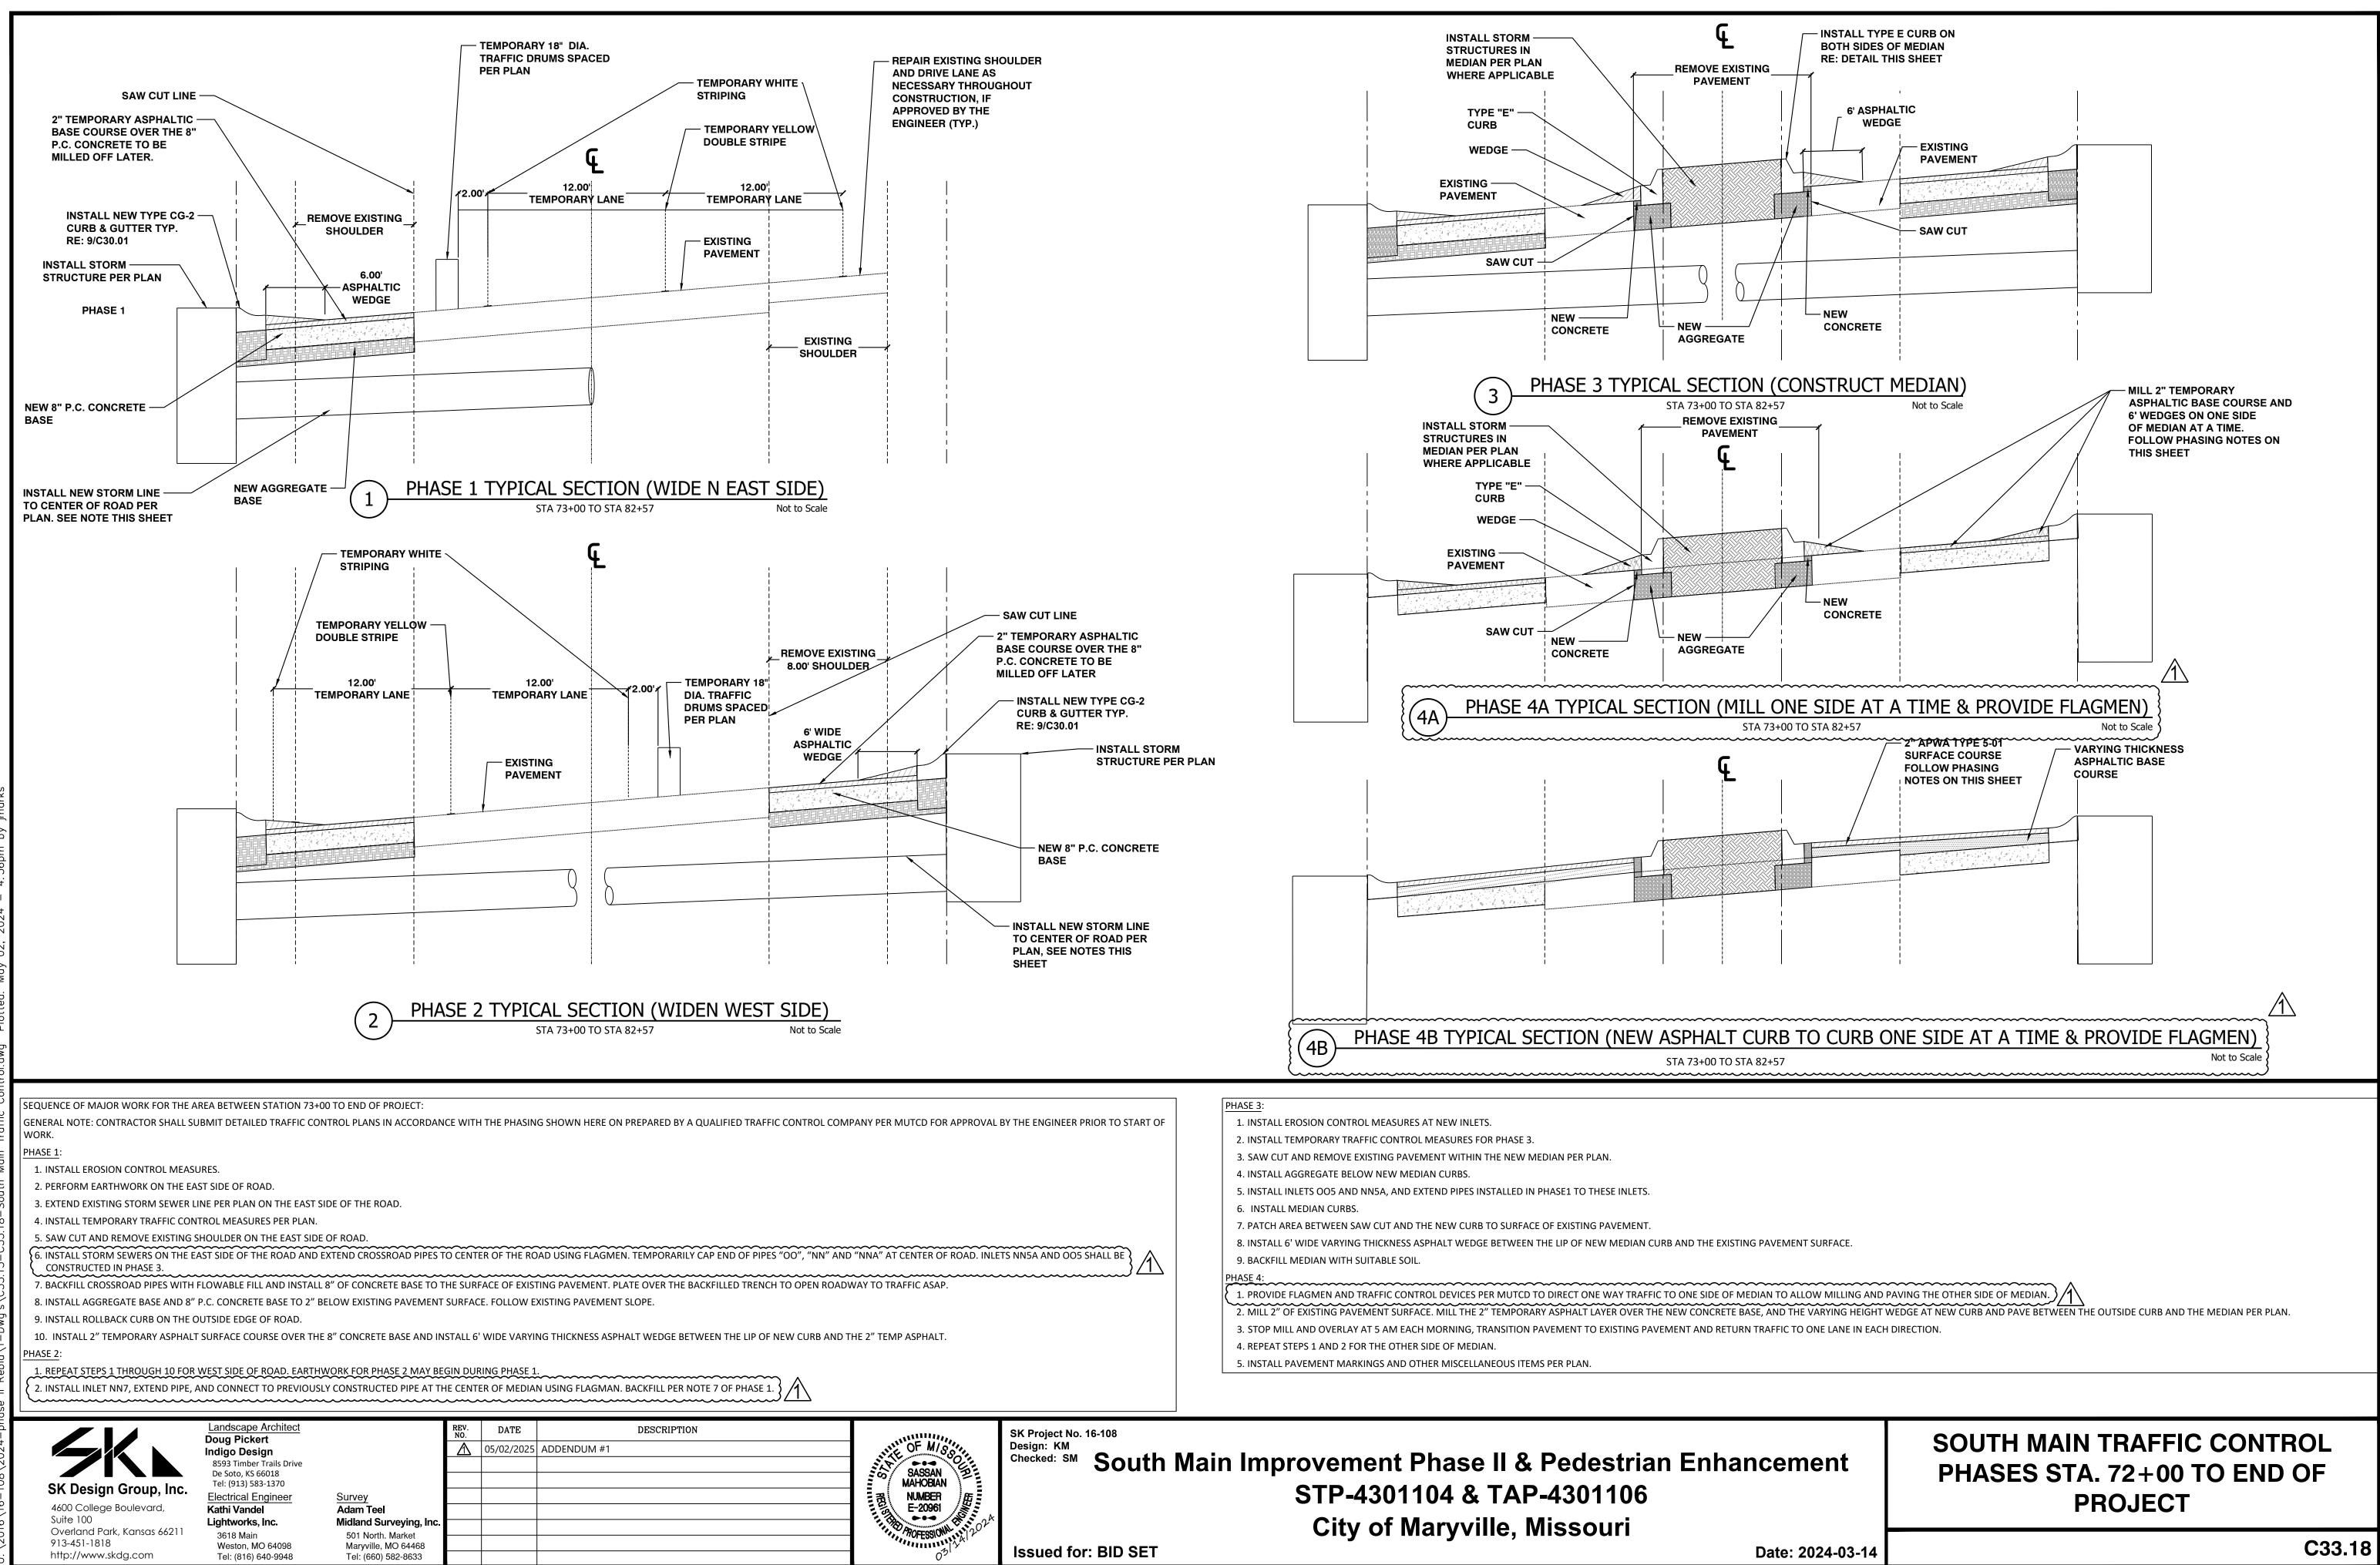

# ELECTRICAL IMPROVEMENT SCHEDULES

POLE NUMBER (RE: PLANS)	DESCRIPTION OF NEW WORK	INGRADE PULLBOX		rlt Tl	SL1 LUMINAIRE STLT TYPE 3M	SL1A LUMINAIRE STLT TYPE 4	SL2 LUMINAIRE PEDESTRIAN	SL3 SIGNAGE UPLIGHT	RA1 LIGHTING POLE ASSEMBLY STLT+PED	RA2 LIGHTING POLE ASSEMBLY STLT ONLY	SHARED TRAFFIC SIGNAL POLE	SH1 FOUNDATION CABLE RETAIN (EA)	SI1 IDENTIF TAGS (EA)	SF1 FUSE HOLDERS (EA)	SG1 UNFUSED KIT GND WIRE (EA)
· ·		NEW	2 СКТ	4СКТ	NEW	NEW	NEW	NEW	NEW	NEW	SHARED	NEW	NEW	NEW	NEW
D201	NP				1		1		1			1	1	2	1
D202	NP				1		1		1			1	1	2	1
D203	NP				1		1		1			1	1	2	1
D2 <b>0</b> 4	NP				1		1		1			1	1	2	1
D205	NA							1							
E101	NP				1		1		1			1	1	2	1
E102	NP				1		1		1			1	1	2	1
E103	NP				1		1		1			1	1	2	1
E104	NP				1		1		1			1	1	2	1
E201	NP				1		1		1			1	1	2	1
E202	NP				1		1		1			1	1	2	1
E203	NP				1		1		1			1	1	2	1
E204	NP				1		1		1			1	1	2	1
E205	NP				1		1		1			1	1	2	1
E206	NP				1					1		1	1	2	1
F101	NP				1		1		1			1	1	2	1
F102	NP				1		1		1			1	1	2	1
F103	NP				1		1		1			1	1	2	1
F104	NP				1		1		1			1	1	2	1
F201	NP				1		1		1			1	1	2	1
F202	NP				1					1		1	1	2	1
F203	NP				1					1		1	1	2	1
F204	NP				1		1		1			1	1	2	1
JS	NE	1													
J8	NE	1													
19	NE	1													
J10	NE	1													
CONTE	NE		1												
CONTE	NE		$\vdash$			$\overline{}$									
<b>v v</b> J11	NE NE	<b>v v</b> 1				• • •	· ·	• •		· ·	• •		•		
		5	1	1	22	0	19	1	19	3		22	22	44	22

## DESCRIPTION OF NEW WORK

NE = NEW STREET LIGHTING EQUIPMENT. RE: EQUIPMENT LIST. LOCATE PER NEW PLANS.

NL = E.C. TO PROVIDE AND INSTALL NEW LUMINAIRE ON SHARED TRAFFIC SIGNAL POLE. TRUSS ARMS SHALL BE PROVIDED AND INSTALLED BY TRAFFIC SIGNAL CON IMPROVEMENT SCHEDULES FOR SPECIFICATION AND ADDITIONAL INFORMATION.

NP = PROVIDE NEW POLE, ARM, FOUNDATION, AND LUMINAIRE. REFER TO EQUIPMENT LIST AND IMPROVEMENT SCHEDULES FOR ADDITIONAL INFORMATION.

NA = PROVIDE NEW ACCENT LUMINAIRE. REFER TO EQUIPMENT LIST AND IMPROVEMENT SCHEDULES FOR ADDITIONAL INFORMATION.


	Landscape Architect Doug Pickert		REV. NO.	DATE	DESCRIPTION
	Indigo Design		$\wedge$	5.2.24	ADDENDUM #1
	8593 Timber Trails Drive De Soto, KS 66018				
SK Design Group, Inc.	Tel: (913) 583-1370				
• •	Electrical Engineer	Survey			
4600 College Boulevard,	Kathi Vandel	Adam Teel			
Suite 100 Overland Park, Kansas 66211	Lightworks, Inc.	Midland Surveying, Inc.			
913-451-1818	3618 Main Weston, MO 64098	501 North. Market Maryville, MO 64468			
http://www.skdg.com	Tel: (816) 640-9948	Tel: (660) 582-8633			

NTRACTOR.	REFER TO EQUIPMENT LIST AND

			C-C		EETLIGH IGID IN			STREETLT CONT.	STREETLT CIRCUIT		2 AW	<u>G, 1 CO</u>	GHT CAE			8 A	TREETLI WG, 1 (	ONDU		10 A \	OLE CA	OND	NG	TRENCHING	
•	FROM	то	DIST	1" (LF)	1-1/2" (LF)	2" (LF)	3" (LF)	NO.	NO.	COND	WIRE LENGTH	ADJUST 5% C-C	ADJUST 6FT PB	BID TOTAL	COND QTY	WIRE LENGTH	ADJUST 5% C-C	ADJUST 6FT PB	BID TOTAL	WIRE LENGTH	ADJUST 5%/CON	BID TOTAL	DORING	(LF)	
	EXISTING CO							$\sim$	$\searrow$	$\frown$				$\checkmark$	$\sim$			$\frown$		$\frown$				$\searrow$	$\mathbf{i}$
			160.00			100		0	2						2	190	34		E04	04	4	00		160	
$\left\langle \right\rangle$	D204	D203	160.00			160		D	2						3	480	24		504	84	4	88		160	$\left  \right\rangle$
	D203	D202	181.00			181		D	2						3	543	27		570	84	4	88		181	
	D202	J11	10.00			10		D	2						3	30	2		32	84	4	88		10	
$\left  \right\rangle$	D201	CONT D	55.00			55		D	2						3	165	8		173	84	4	88		55	$\left  \right\rangle$
$\left \right\rangle$	D205	J10	55.00			55		D	2						3	165	8		173	84	4	88		55	
	J11	D202	160.00			160		D	2						3	480	24		159	84	4	88		160	
$\overline{\ }$	J10		50.00			50	<u> </u>		2	<u> </u>	<u> </u>	<u> </u>		~	3	150	8	<u> </u>	158	84	4	88		50	
					$\sim$	$\sim$	70				210	/ <u> </u>		<u> </u>				$\sim$		$\sim$				70	
	UTIL	CONT E	70.00			170	/0		1	3	210	11		221		F10	26		526		0	0			
	E101	E102	170.00			170		E	1						3	510	26		536	84	4	88		170	
	E102	E103	178.00			178		E	1						3	534	27		561	84	4	88		178	
	E103	E104	162.00			162		E	1						3	486	24		510	84	4	88		162	
	E104	CONT E	112.00			112		E	1						3	336	17		353	84	4	88		112	
	E206	J5	50.00			50		E	2						3	150	8		158	84	4	88		50	
	J5	E205	122.00			122		E	2						3	366	18		384	84	4	88		122	
	E205	E204	174.00			174		E	2						3	522	26		548	84	4	88		174	
	E204	E203	170.00			170		E	2						3	510	26		536	84	4	88		170	
	E203	E202	144.00			144		E	2						3	432	22		454	84	4	88		144	
	E202	E201	136.00			136		E	2						3	408	20		428	84	4	88		136	
	E201	CONT E	68.00			68		E	2						3	204	10		214	84	4	88		68	
						0															0	0		0	
	CONTROLLER	CONTF	225.00				225			3	675	34		709							0	0		225	
	F101	F102	170.00			170	225	F	1	3	075	54		703	3	510	26		536	84	4	88		170	
	F101	F102	162.00			162		F	1						3	486	20		510	84	4	88		162	
	F103	F104	161.00			161		 F	1						3	483	24		507	84	4	88		161	
	F104		88.00			88		 F	1						3	264	13		277	84	4	88		88	
A	F201		85-00			85		'	2						3	255	13		268	84	- 4	88		85	
$\mathbb{A}$					$\searrow$	$\checkmark$	$\geq$		$\frown \checkmark$	$\sim$			$\frown$	$\frown$				$\searrow$		$\searrow$	$\sim$		$\frown$		$\sum$
$\subseteq$		F202	50.00			50	$\mathbf{i}$	F	$\bigwedge_2$				$\sim$		3	150	8		158	84		88	$\sim$	50	$\mathbf{r}$
	F201	F204	205.00			205		 F	2						3	615	31		646	84	4	88		205	
	F201	J9	65.00			65		F	2						3	195	10		205	84	4	88		65	
		F203	60.00			60		' F	2						3	195	9		189	84	4	88		60	
	81	CONT F	175.00			175		F F	3						3	525	9 26		551	84	4	88		175	
	JU	CONTR	175.00					<b>I</b>								525	20							-, J	
	TOTALS	W/ADJUSTME	NT (SUM OF			****								000											
			COLUMNS):		0	3378								929					10641			2470	0	3673	
	BI	D TOTAL (TO N	IEAREST 10):	0	0	3380	300							930					10650			2470	0	3680	I

NOTES:

1. REFER TO TRAFFIC SIGNAL SHEETS FOR STREETLIGHTING CONDUIT AND TRENCHING BETWEEN SHARED TRAFFIC SIGNAL POLES IF "TS" IS NOTED IN LIGHTING IMPROVEMENT COLUMN. IF "TS" IS NOTED, ITEM IS PROVIDED AND INSTALLED BY TRAFFIC SIGNAL CONTRACTOR.

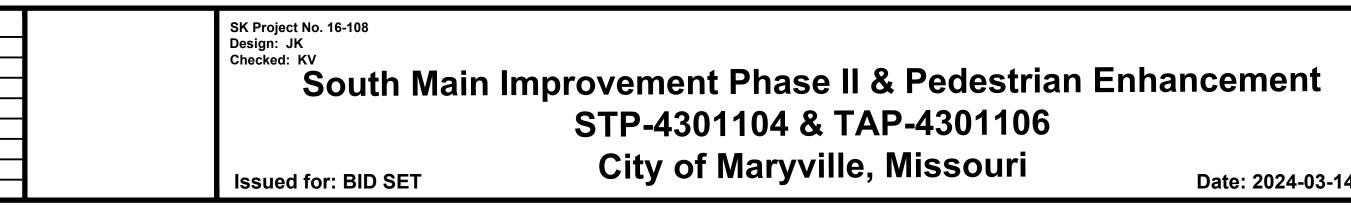

# **ROADWAY LIGHTING** ELECTRICAL IMPROVEMENT SCHEDULES

Date: 2024-03-14

SE002

# ELECTRICAL IMPROVEMENT SCHEDULES

	MARYVILLE	CIRCUIT D-	2	VOLTAG	<u>e drop</u>										
1.19 <b>r</b>	POLE NO. FROM (#)	POLE NO. TO (#)	CABLE LENGTH (FT)	CURRENT DRAW (AMP)	AMPxFT. x2 (AMP-FT)	VOLTAGE DROP (VOLTS)	CUMUL. VOLTAGE DROP (VOLTS)	WIRE SIZE							
1	D204	D203	160.00	1.19	380.80	0.30	0.30	8CU							
2	D203	D202	181.00	2.38	861.56	0.67	0.96	8CU							
3	D202	D201	170.00	3.57	1213.80	0.94	1.90	8CU							
4	D201	CONTD	55.00	4.76	523.60	0.41	2.31	8CU							
				0.00	0.00	0.00	2.31	8CU							
				0.00	0.00	0.00	2.31	8CU							
				0.00	0.00	0.00	2.31	8CU							
			566.00	NGEST RUN	2.31										
		0	0.00	0.00	0.00	0.00		1CU							
		VOLTAGE DROP SUMMARY													
		-		TRANSFORM	IER VOLTAGE	240	VOLTS								
				CONTROLER	VOLTAGE	240.00	VOLTS								
				END OF LON	VOLTS										
		-		MAXIMUM	VOLTS										
				MAXIMUM	% VOLTAGE D	0.96	%								


				VOLTAG	<u>e drop</u>							
.19	POLE NO. FROM	POLE NO. TO	CABLE LENGTH	CURRENT	AMPxFT. x2	VOLTAGE DROP	CUMUL. VOLTAGE DROP	WIRE				
	(#)	(#)	(FT)	(AMP)	(AMP-FT)	(VOLTS)	(VOLTS)	SIZE				
1	E101	E102	170.00	1.19	404.60	0.31	0.31	8CU				
2	E102	E103	170.00	2.38	809.20	0.63	0.94	8CU				
3	E103	E104	170.00	3.57	1213.80	0.94	1.88	8CU				
4	E104	CONTE	112.00	4.76	1066.24	0.83	2.71	8CU				
				0.00	0.00	0.00	2.71	8CU				
				0.00	0.00	0.00	2.71	8CU				
				0.00	0.00	0.00	2.71	8CU				
		622.00 NGEST RUN TOTAL DROF 2.71										
		0	0.00	0.00	0.00	0.00		1CU				
	-		Ā	OLTAGE DRC	P SUMMARY							
		-			IER VOLTAGE	240	VOLTS					
		_		CONTROLER	VOLTAGE	240.00	VOLTS					
				VOLTS								
		-		VOLTS								
MAXIMUM VOLTAGE DRC 2.71 VOLTS MAXIMUM % VOLTAGE D 1.13 %												

ECT:	MARYVILLE	CIRCUIT F-	2						PROJECT		CIRCUIT F-	3
				VOLTAG	E DROP							
	POLE	POLE	CABLE	CURRENT	AMPxFT.	VOLTAGE	CUMUL. VOLTAGE			POLE	POLE	CABLE
l.19	NO. FROM	NO. TO	LENGTH	DRAW	x2	DROP	DROP	WIRE	1.19	NO. FROM	NO. TO	LENGT
	(#)	(#)	(FT)	(AMP)	(AMP-FT)	(VOLTS)	(VOLTS)	SIZE		(#)	(#)	(FT)
1	F203	J9	60.00	1.19	142.80	0.18	0.18	10CU	1	L J8	F202	50.0
1	19	F204	65.00	1.19	154.70	0.19	0.37	10CU	1	L J8	CONTE	175.0
2	F204	F201	205.00	2.38	975.80	1.21	1.58	10CU				
4	F201	CONT F	85.00	4.76	809.20	1.01	2.59	10CU				
				0.00	0.00	0.00		10CU				
				0.00	0.00	0.00		10CU				
				0.00	0.00	0.00	2.59	10CU				
			415.00	NGEST RUN	TOTAL DROP	2.59						225.
		0	0.00	0.00	0.00	0.00		1CU			0	0.
	-		<u> </u>	/OLTAGE DR	OP SUMMARY	,						
				TRANSFORM	/IER VOLTAGE	240	VOLTS					
				CONTROLER VOLTAGE			VOLTS					
				END OF LON	IGEST CIRCUIT	237.41	VOLTS					
				MAXIMUM	VOLTAGE DRC	2.59	VOLTS					
				MAXIMUM	% VOLTAGE D	1.08	%					

	Landscape Architect Doug Pickert		REV. NO.	DATE	DESCRIPTION
	Indigo Design		$\Lambda$	5.2.24	ADDENDUM #1
	8593 Timber Trails Drive De Soto, KS 66018				
SK Design Group, Inc.	Tel: (913) 583-1370				
• •	Electrical Engineer	<u>Survey</u>			
4600 College Boulevard,	Kathi Vandel	Adam Teel			
Suite 100 Overland Park, Kansas 66211	Lightworks, Inc.	Midland Surveying, Inc.			
913-451-1818	3618 Main Weston, MO 64098	501 North. Market Maryville, MO 64468			
http://www.skdg.com	Tel: (816) 640-9948	Tel: (660) 582-8633			

PROJECT:	MARYVILLE CIRCUIT E-2

				VOLTAG	<u>e drop</u>			
							CUMUL.	
	POLE	POLE	CABLE	CURRENT	AMPxFT.	VOLTAGE	VOLTAGE	
1.19	NO. FROM	NO. TO	LENGTH	DRAW	x2	DROP	DROP	WIRE
	(#)	(#)	(FT)	(AMP)	(AMP-FT)	(VOLTS)	(VOLTS)	SIZE
1	E206	J5	50.00	1.19	119.00	0.09	0.09	8CU
1	J5	E205	122.00	1.19	290.36	0.23	0.32	8CU
2	E205	E204	174.00	2.38	828.24	0.64	0.96	8CU
3	E204	E203	170.00	3.57	1213.80	0.94	1.90	8CU
4	E203	E202	144.00	4.76	1370.88	1.06	2.96	8CU
5	E202	E201	136.00	5.95	1618.40	1.25	4.22	8CU
6	E201	CONTE	68.00	7.14	971.04	0.75	4.97	8CU
			864.00	NGEST RUN	TOTAL DROF	4.97		
		0	0.00	0.00	0.00	0.00		1CU
			VOLTAGE DROP SUMMARY					
				TRANSFORM	IER VOLTAGE	240	VOLTS	
				CONTROLER	VOLTAGE	240.00	VOLTS	
				END OF LON	VOLTS			
				VOLTS				
				MAXIMUM	% VOLTAGE D	2.07	%	

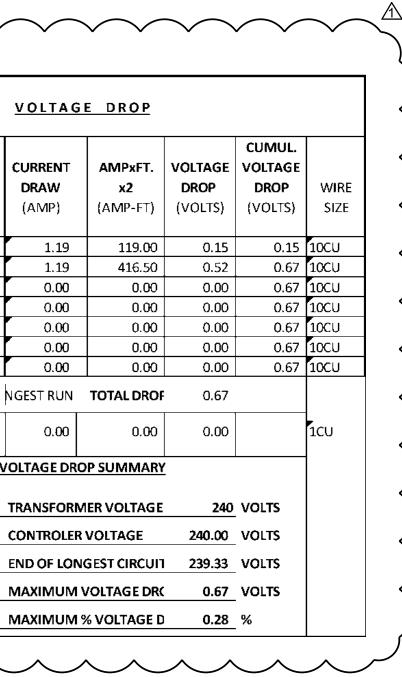

	SK Project No. 16-108 Design: JK Checked: KV <b>South Mai</b> Issued for: BID SET	n Improvement Phase II & Pedestrian E STP-4301104 & TAP-4301106 City of Maryville, Missouri	Enhancement Date: 2024-03-1
--	---	---	--------------------------------


PROJECT: MARYVILLE CIRCUIT F-1

	VOLTAGE DROP							
	POLE	POLE	CABLE	CURRENT	AMPxFT.	VOLTAGE	CUMUL. VOLTAGE	
1.19	NO. FROM	NO. TO	LENGTH	DRAW	x2	DROP	DROP	WIRE
	(#)	(#)	(FT)	(AMP)	(AMP-FT)	(VOLTS)	(VOLTS)	SIZE
1	F101	F102	170.00	1.19	404.60	0.31	0.31	8CU
2	F102	F103	162.00	2.38	771.12	0.60	0.91	8CU
3	F103	F104	161.00	3.57	1149.54	0.89	1.80	8CU
4	F104	CONT F	88.00	4.76	837.76	0.65	2.45	8CU
				0.00	0.00	0.00	2.45	8CU
				0.00	0.00	0.00	2.45	8CU
				0.00	0.00	0.00	2.45	8CU
			581.00	NGEST RUN	TOTAL DROP	2.45		
		0	0.00	0.00	0.00	0.00		1CU
		VOLTAGE DROP SUMMARY						
				TRANSFORM	IER VOLTAGE	240	VOLTS	
			CONTROLER VOLTAGE 240.00 VOLTS					
			END OF LONGEST CIRCUI1 237.55 VOLTS					
			MAXIMUM VOLTAGE DR( 2.45 VOLTS					
				MAXIMUM	% VOLTAGE D	1.02	%	

# ROADWAY LIGHTING VOLTAGE DROP SCHEDULES

Date: 2024-03-14

SE003

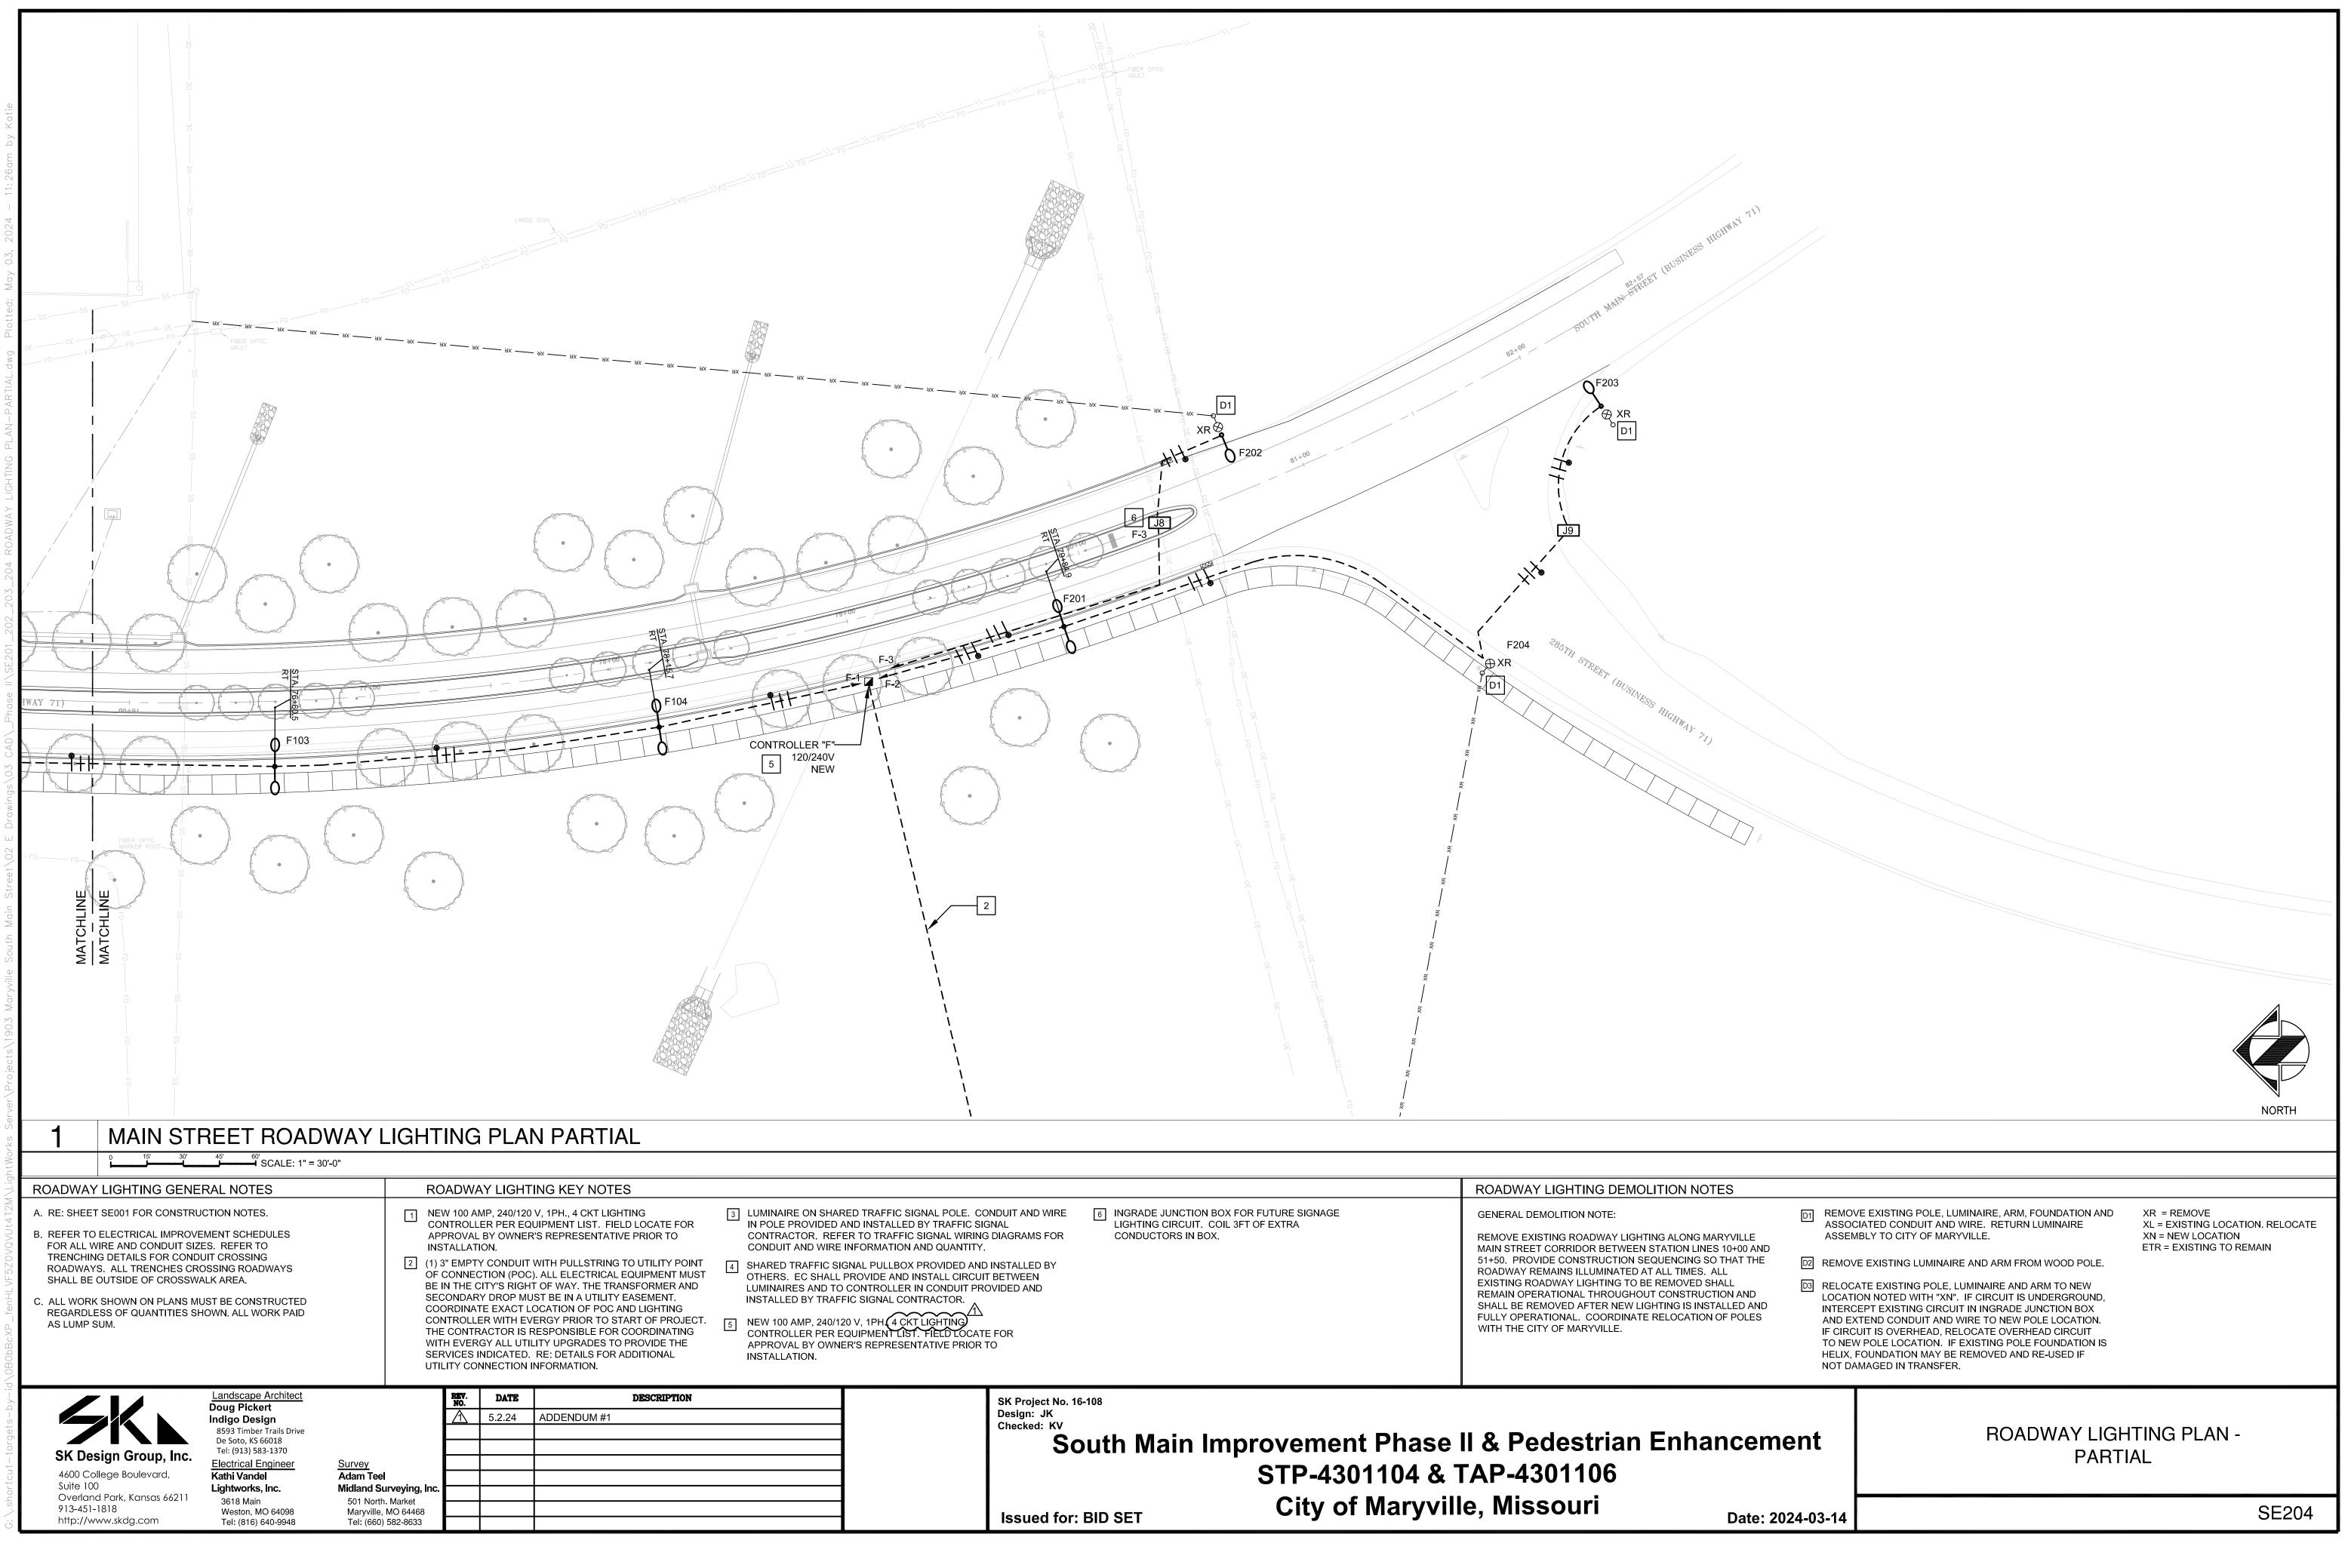

	SK Project No. 16 Design: JK Checked: KV		ont Phase	II & Pedestrian Enhar
C SIGNAL PULLBOX PROVIDED AND IALL PROVIDE AND INSTALL CIRCUI D TO CONTROLLER IN CONDUIT PRO RAFFIC SIGNAL CONTRACTOR. 40/120 V, 1PH, 4 CKT LIGHTING ER EQUIPMENT LIST. FIELD LOCATION WNER'S REPRESENTATIVE PRIOR	T BETWEEN OVIDED AND E FOR			
SHARED TRAFFIC SIGNAL POLE. CO DED AND INSTALLED BY TRAFFIC SIG REFER TO TRAFFIC SIGNAL WIRING VIRE INFORMATION AND QUANTITY.	GNAL G DIAGRAMS FOR	6 INGRADE JUNCTION BOX FOR FUTURE SIGNA LIGHTING CIRCUIT. COIL 3FT OF EXTRA CONDUCTORS IN BOX.	GE	GENERAL DEMOLITION NOTE: REMOVE EXISTING ROADWAY LIGHTING ALONG MAR MAIN STREET CORRIDOR BETWEEN STATION LINES
				ROADWAY LIGHTING DEMOLITION NOTE

South Ma	in Improvement Phase II & Pedestrian E	nhancem
	STP-4301104 & TAP-4301106	
Issued for: BID SET	City of Maryville, Missouri	Date: 2

## STP-4301 (104) and TAP-4301 (106)

# City of Maryville, MO 415 N. Market Street, Maryville, MO 64468

# **REQUEST FOR BID**

### BID OF

Bidder Name\_\_\_\_\_

Bidder Address\_\_\_\_\_

### FOR

CONSTRUCTING OR IMPROVING

South Main Improvement Phase II & Pedestrian Enhancements

STP-4301 (104) & TAP-4301 (106)

South Main, State Highway V to 285<sup>th</sup> Street Nodaway County/Maryville, MO